
DX 78-1 McPherson

KANSAS

Section 30 Township 17 Range 1W

Well No. #1 Ericson

Company Bennett & Roberts

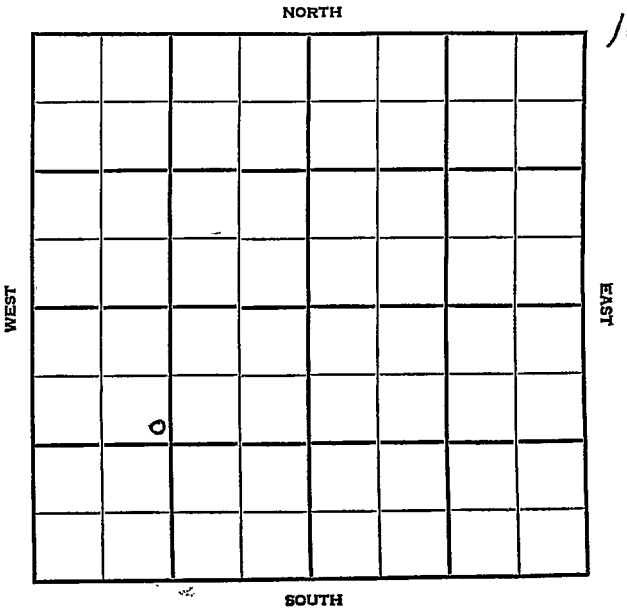

McPherson KANSAS

SEC.	TWP.	R.
30	17	1 W

WELL NO.

1 Erickson FARM

COMPANY

Bennett & Roberts

CONTRACTOR

Co. tools
Roxborows


_____ Ft. from N. Line

_____ Ft. from S. Line

_____ Ft. from E. Line

_____ Ft. from W. Line

SE NW SW

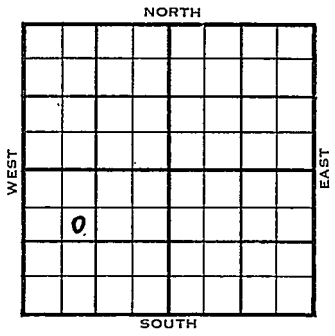

1955	ELEVATION REPORT
6/8	Comm. 6-4-55 8" @ 184 w/135 Drlg. 810'
6/15	D&A Tops: Depth Datum M 2712 1339 TD. 2740

ABANDONED

DX-78

FORM 513 REV. SUNRAY

County McPherson Elev.

Sec. 30 Twp. 17 Rge. 1W

Company Bennett & Roberts

Farm Name Ericson No. 1

TOPS	DEPTH	LOG	DATUM
Anh.			
Tp.			
H.			
Tr.			
Dg.			
Bl.			
L.			
K.C.			
B.K.C.			
Ce.			
C.			
M.			
M.			
K.			
Mz.			
Mo.			
V.			
S.			
S.			
A			
R.			
P€.			
G.			
T.D.			

Loc. in Sec. SE NW SW

Geol.

Contr. Co. tools

Pool Roxborows

FIRST REHORT

JUN 8 '55

Date Comm. 6-4-55

8" @ 184/135 drlg. 810

Co. Lse. No. Sec. T. R.

FORM 513 REV. SUNRAY

County McPherson ✓ Elev. 1373

Sec. 30 Twp. 17 Rge. 1W

Company Bennett & Roberts

Farm Name Ericson No. 1

TOPS	DEPTH	LOG	DATUM
Anh.			
Tp.			
H.			
Tr.			
Dg.			
B.L.			
L.			
K.C.			
B.K.C.			
Ce.			
C.			
M.	2712		1339
M.			
K.			
Mz.			
Mq.			
V.			
S.			
S.			
A			
R.			
P€.			
G.			
T.D.	2740		

Loc. in Sec. SE NW SW

Geol.

Contr. Co. tools

Pool Roxborows



Date Comm. JUN 1 5 1955

8" @ 184/135

D & A

Co. Lse. No. Sec. T. R.