

Section 30 Township 17 Range 1-W

Well No. #1 Lilly


Company Westgate-Greenland

Roxbury Pool

NORTH

WEST

EAST

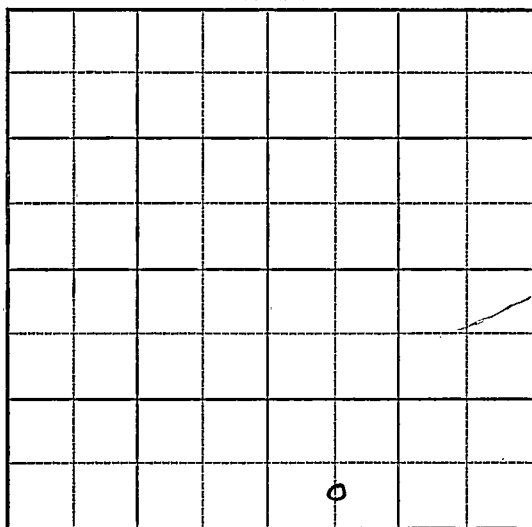

SOUTH

KANSAS


McPherson

Sec. 30 Twp. 17 R. 1-W

Well No. #1 Lilly Farm

Westgate-Greenland Company

(Roxbury Pool)

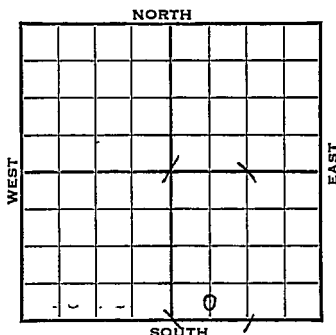

 Ft. from N. Line

330 Ft. from S. Line

 Ft. from E. Line

660 Ft. from W. Line

No Elev-Refused permission to run

1942	Elev. 1342' REPORT
8/27	Location
9/2	"
9/9	"
9/16	Rotary
9/23	10" @ 150' Drlg 2160
9/30	TD 2670. Tstg. 7" - 2658
	Chat 2656 SO 2661-64
10/7	Chat. 2658
	7" - 2659
	Echo Pot. 5400
	Max. 3000
	T.D. 2670.
	Gravity 35.
1952	COMPLETED
2/6	10" @150' Lans. 2090
	Miss L 2658
	7" @ 2659
	OTD 2670
	Was Miss L production
	Set 63' of 5" liner @ 2709
	Drlg. 2807'
2/13	SWD Well TD 2920
	10" @ 150 Lans. 2090 Miss. 2658
	7" @ 2659 OTD 2670 DD 2920
	Comp. for SWD well
	ABANDONED

McPherson

KANSAS


Map No. 42 Sec. 30 Twp. 17 R. 1WWell No. 1 LillyWestgate-Greenland

Company

FIRST REPORT

Contractor

C SL SW SE

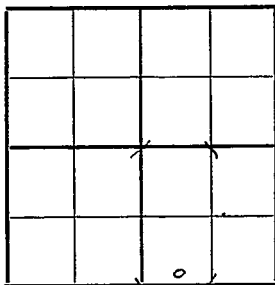SECTION PLAT Ft. from N. Line330 Ft. from S. Line Ft. from E. Line660 Ft. from W. Line**ROXBURY POOL**Location XXRig up Drilling and Remarks: **RECORD**Cased in., ft.Sand Gas Oil Total Depth **PRODUCTION**1st 24 hrs. Nat. 1st 24 hrs. after shot Gas Cu. Ft.Dry Hole Abandoned

Date


AUG 27 1942 19 S. J. LEWIS Scout

McPhers on KANSAS

Map No. 42 Sec. 30 Twp. 17 R. 1WWell No. 1 LillyWestgate-Greenland CompanyCOMPLETED Contractor

C SL SW SE

SECTION PLAT

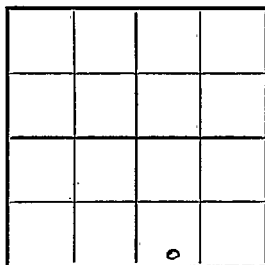 Ft. from N. Line330 Ft. from S. Line Ft. from E. Line660 Ft. from W. Line

ROXBURY POOL

Location Rig up

Drilling and Remarks:

*Cha 82658**7" C 2659**Echo Pot 5400**Max 3000**35° SW*

RECORD

Cased in., ft.Sand Gas Oil Total Depth 2670

PRODUCTION

1st 24 hrs. Nat. 1st 24 hrs. after shot Gas Cu. Ft.Dry Hole Abandoned

Date

OCT 7 1942 19


S. J. LEWIS Scout

County McPherson State Kansas
 Sec. 30 (Blk. Twp.) 17 (Sur. Rge.) 1W Map No.

Operator Westgate Greenland

Well No. 1 Farm Lilly

Elev. 1342 Location C S/2 SW SE

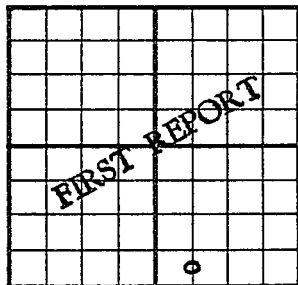

330 Ft. From S Line SE

660 Ft. From W Line Quarter

Ist. Report FEB 6 1952

Completion

Remarks

OWWO


Spudding Date

Drlg. Data

10" @ 150 Lens 2090 Miss L 2658 7" @
2659 OTD 2670 was Miss L. production
set 63' of 5" liner @ 2709 Drlg. 2807

J. G. McGEHEE

County McPherson State Kansas
 Sec. 30 (Blk. 17 (Sur. 1W Map No.
 (Twp.) (Rge.)
 Operator Westgate-Greenland
 Well No. 1 Farm Lilly
 Elev. 1342 Location C S L SW SE

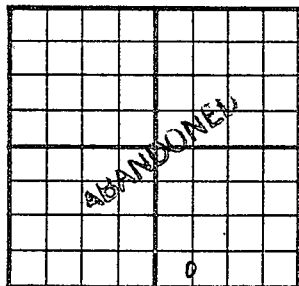

330 Ft. From S Line SE
660 Ft. From W Line Quarter
 1st. Report
 Completion FEB 13 1952
 Remarks OWWO
 Spudding Date

Drlg. Data SWD well TD 2920
10" @ 150 Lans. 2090 Miss. 2658
7" @ 2659 OTD 2670 DD 2920
Comp. for SWD well

173

J. G. McGEHEE