


Section 30 Township 17 Range 3-W

Well No. #1 Bengtson "B"

Company Auto Ordnance

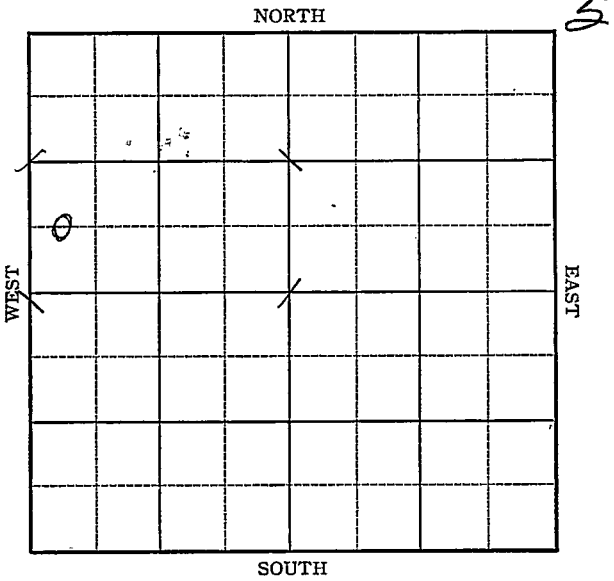

Sec. 30 Twp. 17 R. 3-W

Well No. #1 Bengtson "B" Farm

Auto Ordnance Company


Lindsborg Pool

 Ft. from N. Line

660 Ft. from S. Line

 Ft. from E. Line

330 Ft. from W. Line

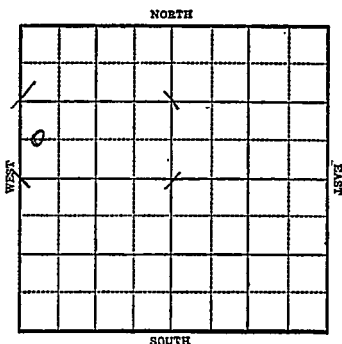

1943

R E P O R T

3/10 Ponds

3/17 13" Casing set 180'
8" -Casing set 368' WOC.

3/24 Drlg. 1300'
3/31 Miss 2947 Drlg. 2995

4/7 Misiner 3356
Viola 3366
T.D. 3368
5" @ 3366 RUST.

4/14 T.D. 3375 4300 acid
Temp Pot. 25.

4/21 Viola 3366
5" @ 3366'
T.D. 3375'
4300 gal. acid
Pump 301 Pot.
Gravity 36

COMPLETED

McPherson

KANSASMap No. 42 Sec. 30 Twp. 17 R. 3WWell No. 1 Bengtson "B"

Auto Ordnance

Company

FIRST REPORT

Contractor

C WL SW NW

SECTION PLAT

o			

_____ Ft. from N. Line

660 Ft. from S. Line

_____ Ft. from E. Line

330 Ft. from W. Line**LINDSBORG POOL**

Location _____

Rig up _____

Drilling and Remarks:

Ponds

RECORD

Cased _____ in., _____ ft.

Sand _____

Gas _____

Oil _____

Total Depth _____

PRODUCTION

1st 24 hrs. Nat. _____

1st 24 hrs. after shot _____

Gas _____ Cu. Ft.

Dry Hole _____

Abandoned _____

Date

MAR 10 1943 19S. J. LEWIS Scout

McPherson

KANSAS
 Map No. 72 Sec. 30 Twp. 17 R. 3W

Well No. 1 Bengtson "B"

Auto Ordnance Company

COMPLETED Contractor

C WL SW NW

SECTION PLAT

_____ Ft. from N. Line

660 Ft. from S. Line

_____ Ft. from E. Line

330 Ft. from W. Line

LINDSBORG POOL

Location _____

Rig up _____

Drilling and Remarks:

Vista 3366
5" C 3366
#300 acid
Pump 301 Pat.

36° Gr

RECORD

Cased _____ in., _____ ft.

Sand _____

Gas _____

Oil _____

Total Depth 3375

PRODUCTION

1st 24 hrs. Nat. _____

1st 24 hrs. after shot _____

Gas _____ Cu. Ft.

Dry Hole _____

Abandoned _____

Date

APR 21 1943

S. J. LEWIS Scout