


Section 31 Township _____ Range 9W

Well No. #1 Schraeder

Company B & R Drlg.

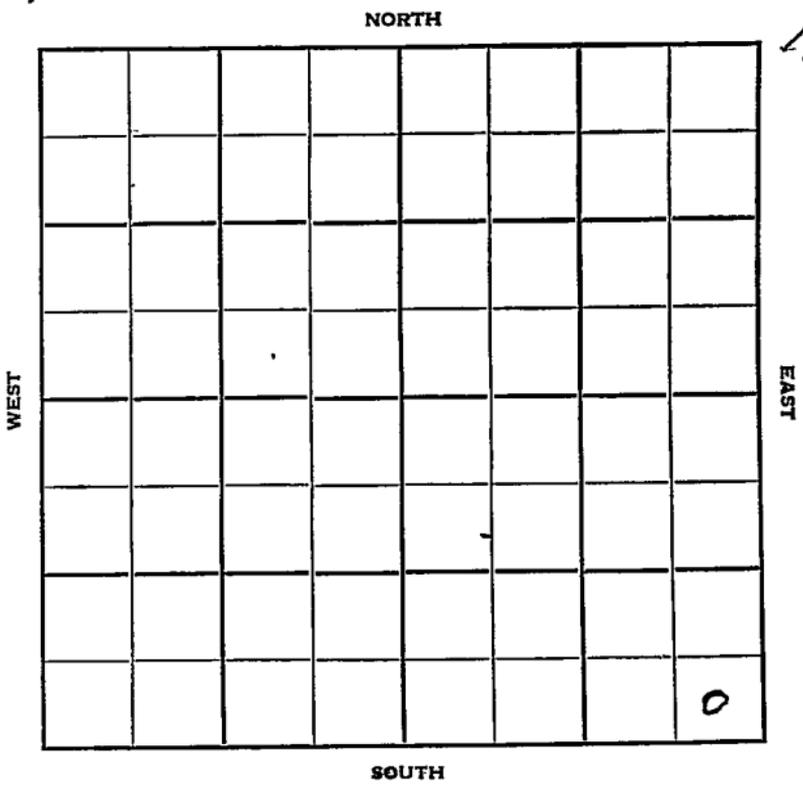

16

Ellsworth

KANSAS

Sec. 31 Twp. 17 R. 9 W

Well No. # 1 Schraeder Farm

B & R Drlg. Company

Stoltenberg Contractor


Ft. from N. Line

330 Ft. from S. Line

330 Ft. from E. Line

Ft. from W. Line

SE SE SE
Skelly DHM

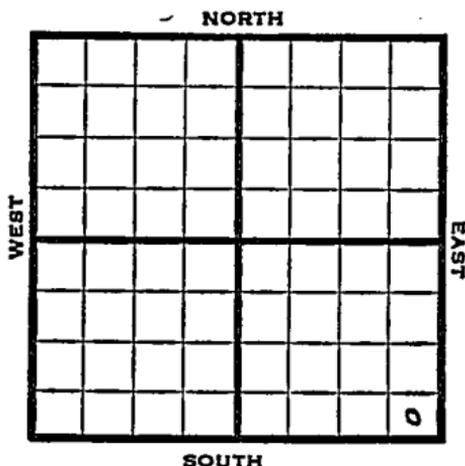

1951

Elev. 1747' REPORT

11/7


Spud 10-31-51
10" @ 183'
Drlg. 3162'

1952
1 /9

Spud 10-31-51
D&A TD 3238
10" @ 183
Lans. 2878
Arb. 3221
5" @ 3222
TD 3228
CO to 3222 W/2 boph
DST 3222-28 opn 1 hr. Rec. 150' oil
25' wtr CO to 3228
S/2 boph 2 gwph 12 hr.
P/20 bopd Dec. to 8 bopd
DD 3238 wtr
D&A

ABANDONED

County Ellsworth State Kansas
 Sec. 31 (Blk. 17) (Sur. 9W) (Twp. 17) (Rge. 9W) Map No.
 Operator B & R Drlg.
 Well No. 1 Farm Schraeder
 Elev. 1747 Location SE SE SE

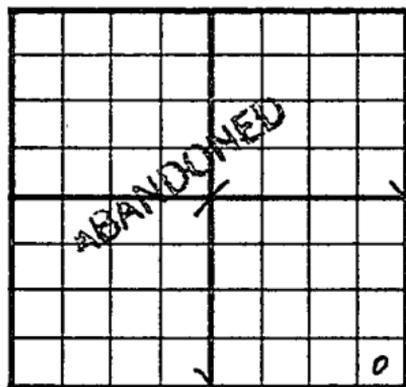

330 Ft. From S Line SE

330 Ft. From E Line Quarter

1st. Report

Completion JAN 9 1952

Remarks Stoltenberg Pool

Spudding Date 10-31-51

Drlg. Data D & A TD 3238

10" @ 183 Lans. 2878 Arb. 3221

5" @ 3222 TD 3228 CO to 3222 S/ 2 boph

DST 3222-28 open 1 hr. Rec. 150' oil

25' water CO to 3228 S/ 2 boph 2 gwph

12 hr. P/ 20 bopd Dec. to 8 bopd

DD 3238 water

D & A

J. E. TYRA