


Section 31 Township 17 Range 9 W

Well No. # 1 Alfred Sturm

Company M & L Oil Co.

12

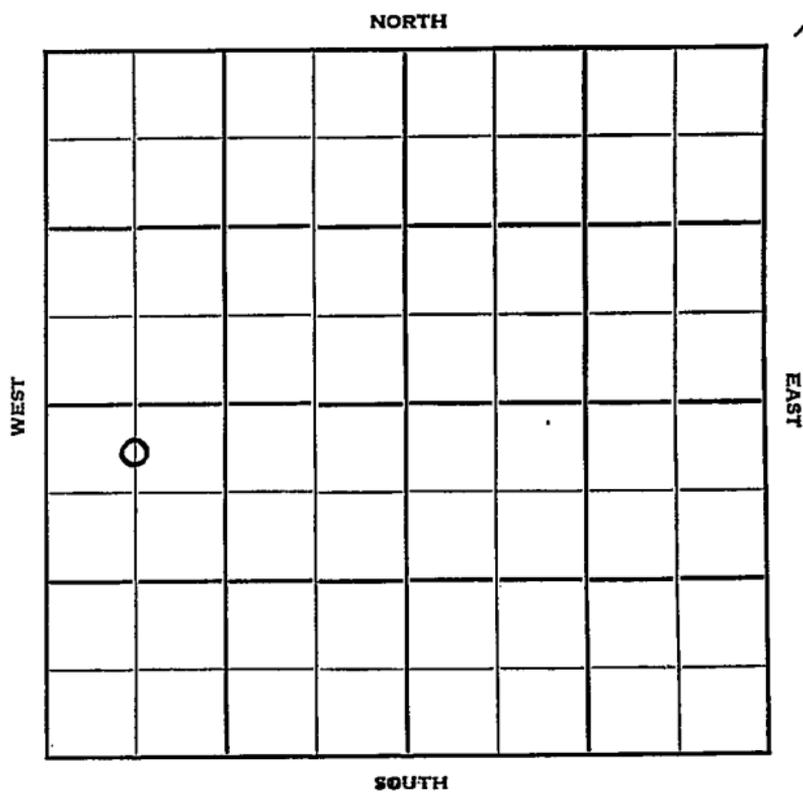

Sec. 31 Twp. 17 R. 9W

Well No. #1 Alfred Sturn Farm

M & L Oil Co. Company

Contractor


330 Ft. from N. Line

_____ Ft. from S. Line

_____ Ft. from E. Line

660 Ft. from W. Line

C N L NW SW

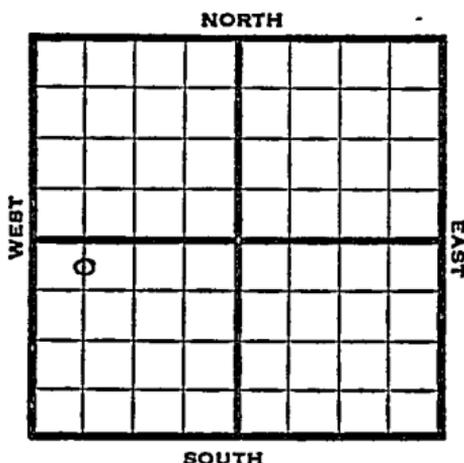

1952

Elev. 1767'

REPORT

2/20

Spud 2-14-52
8" @ 375'

Drlg. 2225'

2/27

Spud 2-14-52
D&A TD 3265
8" @ 375

DST 2477-85 Rec. mud & wtr.
KC 2829 Arb. 3231

DST 3250-? Rec. SW TD 3265
D&A

ABANDONED


County Ellsworth State Kansas

Sec. 31 (Blk.) 17 (Sur.) 9W Map No. (Twp.) (Rge.)

Operator M & L Oil Co.

Well No. 1 Farm Alfred Sturn

Elev. _____ Location C N L. NW SW

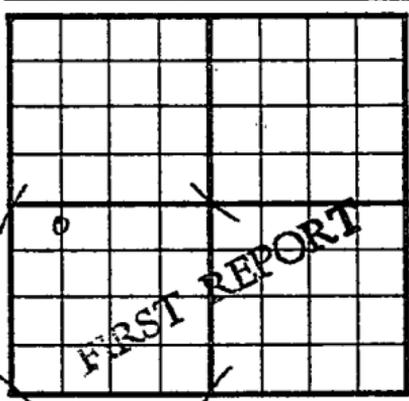

330 Ft. From N Line SW

660 Ft. From W Line Quarter

1st. Report FEB 20 1952

Completion _____


Remarks _____

Mallard Drig. - Contr.

Spudding Date 2-14-52

Drig. Data _____

8" @ 375 drig. 2225

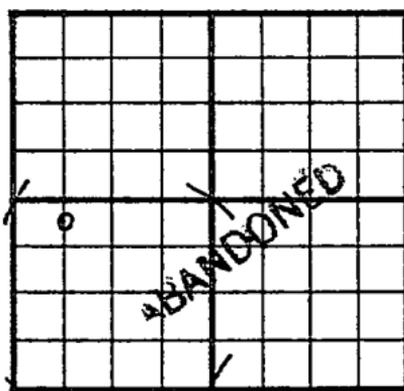County Ellsworth State KansasSec. 31 (Blk. Twp.) 17 (Sur. Rge.) 9W Map No.Operator M & L Oil Co.Well No. 1 Farm Alfred SturnElev. 1767 Location C N L NW SW330 Ft. From N Line SW660 Ft. From W Line Quarter1st. ReportCompletion FEB 27 1952RemarksMallard Drlg. - Contr.Spudding Date 2-14-52Drig. Data D & A TD 32658" @ 375 DST 2477-85 Rec. mud & waterKC 2829 Arb. 3231 DST 3250-?Rec. SW TD 3265D & A

J. G. McGEHEE