

*Ellsworth*


O.W.W.O.

Form 51-5M-1-30-38840

Map No. KANSAS Sec. 31 Twp. 17 R. 9<sup>W</sup>

Well No. 1-2 turns "C" Farm

WESTWORTH OIL & GAS Company

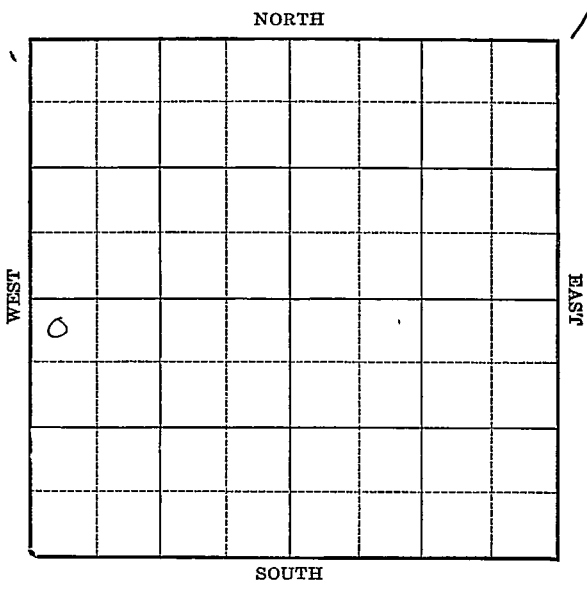

Location \_\_\_\_\_  
Drilling Remarks \_\_\_\_\_

Rig Up \_\_\_\_\_  
Drilling Remarks \_\_\_\_\_

\_\_\_\_\_  
\_\_\_\_\_  
**RECORD**

**PRODUCTION**

Cased \_\_\_\_\_ in. \_\_\_\_\_ ft.  
Sand \_\_\_\_\_  
Gas \_\_\_\_\_  
Oil \_\_\_\_\_  
Total Depth \_\_\_\_\_

1st 24 hrs. Nat. \_\_\_\_\_  
1st 24 hrs. after shot \_\_\_\_\_  
Gas \_\_\_\_\_ cu. ft. \_\_\_\_\_  
Dry Hole \_\_\_\_\_  
Abandoned \_\_\_\_\_

Map No. KANSAS Sec. 31 Twp. 17 R. 9W

Well No. 1 - Sturm "C" Farm  
Alford Oil & Gas Company

NORTH

NW NW SW


330 Ft. from N. Line

\_\_\_\_\_ Ft. from S. Line

\_\_\_\_\_ Ft. from E. Line

330 Ft. from W. Line

1931

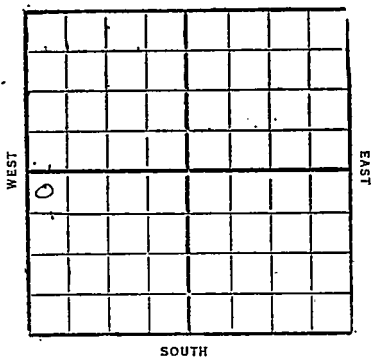

Date	REPORT
1/28	Loc
2/4	Rig
2/11	Run up
2/18	Drig 225'
2/25	" 600'
3/4	" 1324'
3/11	" 1745'
3/18	" 2100'
3/25	TD 2425' UIR 10"
4/1	TD 2450
	UIR 10" - 2075'
4/8	UIR 10" - 2205'
4/11	Estimated 3 M gas at 2485 Drilling 2490'
	(Telegram)
4/15	Est 2 to 3 M gas 2480-85 1 barrel water 2620-25 Drig 2740'
4/22	Had 3 barrel water 2990 Drig 3010'
	(over)

OVER

- 4/29. 8"-3040  
show oil 3080-95  
dry 3105'
- 5/5- Top Conglomerate 3198  
Green shale 3242-43  
Top Silc lime 3243  
T.D. 3245' show oil  
set 65/8"-3193  
Will reduce hole at  
3145'
- 5/8- Top Silc lime 3243  
set 70 ft 5" liner 3245  
Rainbow show in top  
show water 3271  
1 1/2 bailer water hour 3276  
2 " " " 3281  
4 " " " 3284  
slight sulphur odor  
T.D. 3295' HFW  
very hard formation  
Will drill ahead
- 5/13- S.D. 3295' HFW
- 5/20- T.D. 3295'  
P.B. to 3164 1/2'  
To shoot 40 qt 3243-64
- 5/27- Top Silc lime 3243  
show oil  
HFW 3295'  
T.D. 3295'  
P.B. to 3264  
shot 30 qt 3242-63  
Dref & Abandon

#1 Sturn "C"

O.W.W.O.

1953

12/30

OWDD for SWD  
Abr. 3231'  
OTD 3265'  
DD 3650'  
5" @ 3336', WOC

1954

1/6

WOC

1/13

WOC

1/20

SWD well TD 3650 Arb. 3231  
OTD 3265 DD 3650 5" @ 3336  
CO to 3301 25/3260-64 8/3271-72  
12/3268-70 36/3254-56 24/3243-47  
24/3236-40 5/16 GWPH 16/3231-34  
SP 3263 B/14 BOPH 4 hr. 1000 A  
S/4 BWPH Regan 3645 CO to 3650  
Comp. for SWD well

**ABANDONED**

Map No. KANSAS Sec. 31 Twp. 17 R. 9 W

Well No. 1 Sturm

Gilmore Oil & Gas Company

Contractor

SECTION PLAT

0.30 Ft. from N. Line

..... Ft. from S. Line

..... Ft. from E. Line

0.30 Ft. from W. Line

0			

FIRST REPORTS

Location ✓

Rig up .....

Drilling and Remarks:

RECORD

Cased ..... in., ..... ft.

Sand .....

Gas .....

Oil .....

Total Depth .....

PRODUCTION

1st 24 hrs. Nat. ....

1st 24 hrs. after shot .....

Gas ..... Cu. Ft.

Dry Hole .....

Abandoned .....

Date

JAN 28 1931

S. J. LEWIS Scout

*Ellsworth*

45 KANSAS Map No. Sec. 31 Twp. 17 R. 9<sup>W</sup>

Well No. 1 *Sturm*

*Gilmore Oil Co et al* Company

Contractor

COMPLETED

SECTION PLAT

330 Ft. from N. Line

Ft. from S. Line

Ft. from E. Line

330 Ft. from W. Line

ABANDONED

0			

Location.....

Rig up.....

Drilling and Remarks:

*Top Sili 3743' shot  
Ore. IFW 3295'  
Plugged back to 3264'  
Shot 30/3742-63'*

*D+u*

RECORD

Cased.....in., .....ft.

Sand.....

Gas.....

Oil.....

Total Depth *3295*

PRODUCTION

1st 24 hrs. Nat.....

1st 24 hrs. after shot.....

Gas.....Cu. Ft.

Dry Hole

Abandoned

Date

MAY 27 1931

CHAS. L. SHERWOOD



