

Section 31 Township 17 Range 1W

Well No. 3 Van Meter

Company. Westgate-Greenland et al

Crowther

NORTH

16

WEST

EAST

SOUTH

McPherson ✓

KANSAS

Sec. 31 Twp. 17 R. 1W

Well No. #3 Van Meter Farm
Westgate-Greenland etal Company


Crowther

 Ft. from N. Line

990 Ft. from S. Line

990 Ft. from E. Line

 Ft. from W. Line

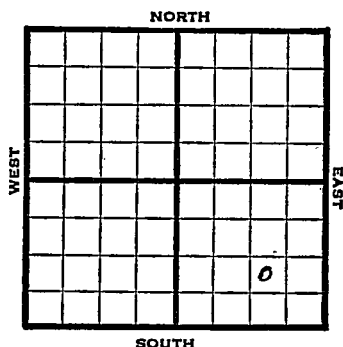

NW SE SE

1947

Elev. 1372' REPORT

11/5

surface hole

11/12

Lans. 2130'
Miss 2708'
Total Depth 2758'

ABANDONED

Map No. _____ Sec. 31 Twp. 17 R. 1W

Well No. 3 Van Meter

Westgate-Greenland etal. Company

FIRST REPORT Contractor

NW SE SE

SECTION PLAT

_____ Ft. from N. Line

990 Ft. from S. Line

990 Ft. from E. Line

_____ Ft. from W. Line

			o

McPherson County

Location _____

Rig up _____

Drilling and Remarks:

surface hole

RECORD

Cased _____ in., _____ ft.

Sand _____

Gas _____

Oil _____

Total Depth _____

PRODUCTION

1st 24 hrs. Nat. _____

1st 24 hrs. after shot _____

Gas _____ Cu. Ft.

Dry Hole _____

Abandoned _____

Date

NOV 5 1947 19

S. J. LEWIS Scout

Map No. 42 Sec. 31 Twp. 17 R. 1W

Well No. 3 Van Meter

Westgate-Greenland etal. Company

ABANDONED

Contractor

NW SE SE

E11872
SECTION PLAT

			0

 Ft. from N. Line

990 Ft. from S. Line

990 Ft. from E. Line

 Ft. from W. Line

McPherson County

Location

Rig up

Drilling and Remarks:

Lane 2130

Miss 2708

RECORD

Cased in., ft.

Sand

Gas

Oil

Total Depth 2758

PRODUCTION

1st 24 hrs. Nat.

1st 24 hrs. after shot

Gas Cu. Ft.

Dry Hole

Abandoned

Date

NOV 12 1947

19

S. J. LEWIS

Scout