


Section 31 Township 17 Range 1W

Well No. #7 Crumpacker

Company Bennett & Roberts

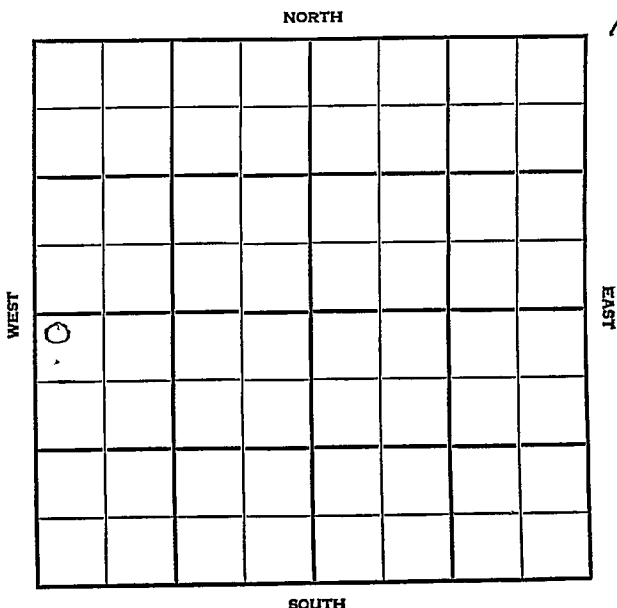

McPherson

KANSAS

SEC.	TWP.	R.
31	17	1W

WELL NO.

7 Crumpacker

FARM

COMPANY

Bennett & Roberts

CONTRACTOR

Co. Tools

Georob


_____ Ft. from N. Line

_____ Ft. from S. Line

_____ Ft. from E. Line

_____ Ft. from W. Line

NW NW SW

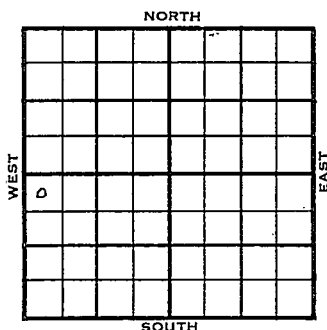

1955

ELEVATION

REPORT

5/26

M I M

6/15

Comm 5-17-55

8 5/8", @164/110 5 1/2" @2755/75

Co to 2750 6/2726-28 6/2728-30

6/2722-24, 6/2714-16, S/3 bwph, sq

CO to 2740 17/2722-28, 500A Temp abd.

Tops: Depth Datum

KC 2138 762

M. 2720 1344

TD. 2755

ABANDONED

FORM 513 REV. SUNRAY

Farm Name Crumpacker No. 7

TOPS	DEPTH	LOG	DATUM	Loc. in Sec. _____
Anh.				NW NW SW
TP.				
H.				
Tr.				
Dg.				
BL.				
L.				Geol. _____
K.C.				Contr. _____
B.K.C.				Co. tools _____
Ce.				
C.				Pool _____
M.				Georob _____
M.				
K.				
Mz.				
Me.				
V.				
S.				
S.				
A.				
R.				
PC.				
G.				
TD.				

M I M

३

County McPherson ✓ Elev. 1376Sec. 31 Twp. 17 Rge. 1WCompany Bennett & RobertsFarm Name Crumpacker No. 7

TOPS	DEPTH	LOG	DATUM	Loc. in Sec.
Anh.				NW NW SW
Tr.				
Dg.				
Bl.				
L.				
K.C.	2138		762	Geol.
B.K.C.				Contr.
Ce.				Co. tools
C.	2720		1344	Pool
M.				Georob
M.				
K.				
Mz.				
Me.				
V.				
S.				
S.				
A.				
R.				
Pe.				
G.				
T.D.	2755			

Date Comm. 5-17-55

JUN 15 1955

8 5/8" @ 164/110 5 1/2" @ 2755/75

CO to 2750 6/ 2726-28 6/ 2728-30

6/ 2722-24 6/ 2714-16 S/ 3 bwph

sq CO to 2740 17/ 2722-28 500 A

S/ 9 bwph SSO sq

Temp. abd.

