


DX 78-1 McPherson

Kansas

Section 31 Township 17 Range 1W

Well No. 1 Phillips

Company Bennett & Roberts

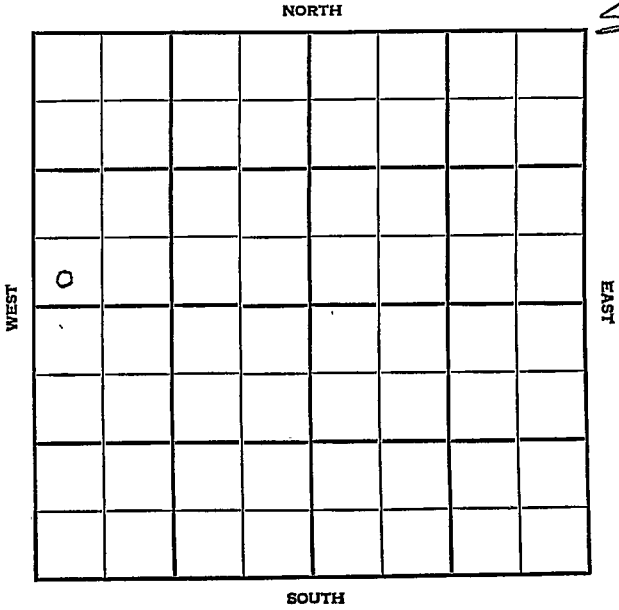

McPherson KANSAS

SEC.	TWP.	R.
31	17	1W

WELL NO.

1 Phillips

FARM

COMPANY

Bennett & Roberts

CONTRACTOR

Co. Tools


S. Roxbury Pool

Ft. from N. Line

330 Ft. from S. Line

Ft. from E. Line

330 Ft. from W. Line

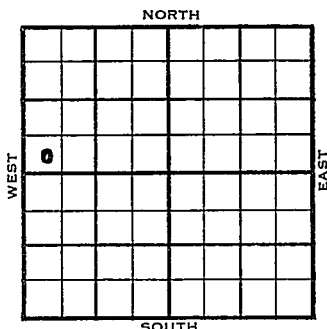

SW SW NW

ELEVATION

REPORT

1955

1357'

4/27

Dr1g. 2535'

6/1

Misa 2688

TD 2750

5 1/2" @ 2740 CO 12/2700-04

12/2703-05 S/7 BFPH FU 900' oil

450' sw 16 hr

Comp 22 bopd 40 bw

COMPLETED



Operator Bennett & Roberts

Well No. **1** Farm **Phillips**

Elev.	1357	Location	SW SW NW
-------	------	----------	----------

0

FIRST REPORT

330 Ft. From S Line NW

330 Ft. From **W** Line Quarter

1st. Report APR 27 1955

Completion

Remarks

Co. tools

Spudding Date: _____

Drlg. Data S. Roxbury Pool

drlg. 2535

FABEN GILSTRAP

County McPherson Elev. 1357Sec. 31 Twp. 17 Rge. 1WCompany Bennett & RobertsFarmName Phillips No. 1

TOPS	DEPTH	LOG	DATUM
Anh.			
TP.			
H.			
Tr.			
Dg.			
BL.			
L.			
K.C.			
B.K.C.			
Ce.			
C.			
M. <u>iso</u>	<u>2688</u>		<u>1331</u>
M.			
K.			
Mz.			
Me.			
V.			
S.			
S.			
A.			
R.			
PE.			
G.			
T.D.	<u>2750</u>		

Loc. in Sec. SW SW NW

Geol. _____

Contr. _____

Pool _____

S. Roxbury

COMPLETE

Date Comm. JUN 1 19555 1/2" @ 2749. CO 12/ 2700-0412/ 2703-05 S/ 7. bfph FU 900' oil450' sw 16 hr.Comp. 22 bopd 40 bw