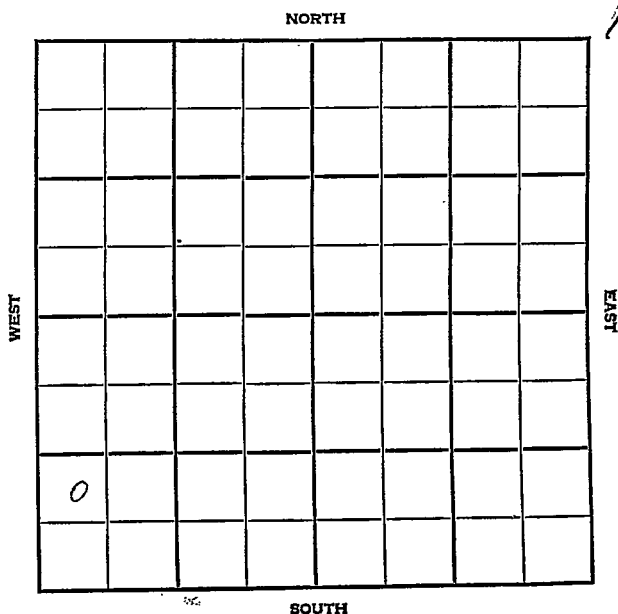


McPherson

Section 31 Township 17 Range 1WWell No #14 CrumpackerCompany Bennett & Roberts

SWDW

McPherson

KANSAS

SEC.	TWP.	R.
31	17	1W

WELL NO.

4 Crumpacker

FARM

COMPANY

Bennett & Roberts

CONTRACTOR

Co. Tools

Georab


_____ Ft. from N. Line

_____ Ft. from S. Line

_____ Ft. from E. Line

_____ Ft. from W. Line

NW SW SW

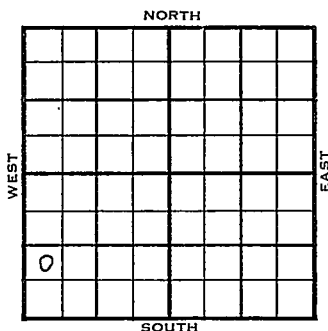

1955	ELEVATION	REPORT
	1369'	
6/22	M 2787, TD 2802 DD 3309	
6/29	OTD 2802 DD 3309 5½ @ 3555, CO to 3588 Comp. for SWD well Tops: Depth Datum M. 2787 1418 A. 3538 2169 TD. 3838	
ABANDONED		

SWDW

County McPherson Elev. 1369
 Sec. 31 Twp. 17 Rge. 1W
 Company Bennett & Roberts
 Farm Name Crumpacker No. 4

TOPS	DEPTH	LOG	DATUM
Anh.			
Top			
H.			
Tr.			
Dg.			
Bl.			
L.			
K.C.			
B.K.C.			
Ce.			
C.	2787		
M.			
M.			
K.			
Mz.			
Me.			
V.			
S.			
S.			
A			
R.			
Pe.			
G.			
T.D.	2802		

Loc. in Sec.

NW SW SW


Geol.

Contr.

Co. tools

Pool

Georab

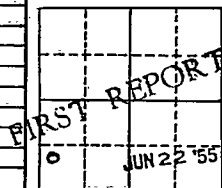

Date Comm.

DD 3309

SWDW

County McPherson Elev. 1369
Sec. 31 Twp. 17 Rge. 1W
Company Bennett & Roberts
Farm Name Crumpacker No. 4

TOPS	DEPTH	LOG	DATUM
Anh.			
T.P.			
H.			
Tr.			
Dg.			
BL.			
L.			
K.C.			
B.K.C.			
Ce.			
C.			
M.	2787		1418
M.			
K.			
Mz.			
Mq.			
V.			
S.			
S.			
A	3538		2169
R.			
Pe.			
G.			
T.D.	3838		

Loc. in Sec. NW SW SW
Geol. _____
Contr. _____
Co. tools _____
Pool _____
Georab _____

ABANDONED

0

Date Comm. JUN 29 1955
OTD 2802 DD 3309 5 1/2" @ 3555
CO to 3588 Comp. for SWD well