


31
McPherson KANSAS

DX 78-1

Section 31 Township 17 Range 1W

Well No. 4 Crumpacker

Company B & R Drlg.

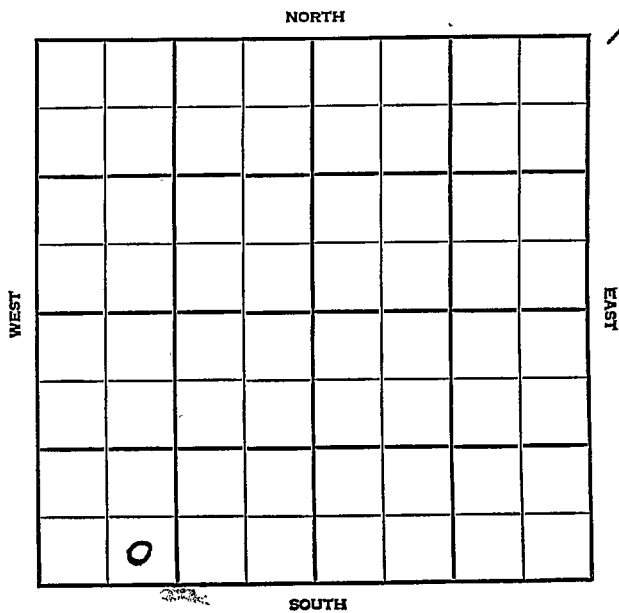

McPherson KANSAS

SEC.	31	TWP.	17	R.	1W ✓
------	----	------	----	----	------

WELL NO. **4 Crumpacker** FARM

COMPANY **B & R Drlg.**

CONTRACTOR **Shields
Georob Pool**


_____ Ft. from N. Line

330

_____ Ft. from S. Line

_____ Ft. from E. Line

990 _____ Ft. from W. Line

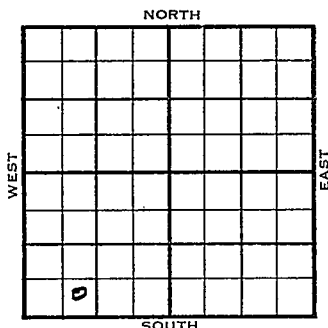

SE SW SW

	ELEVATION	REPORT
--	-----------	--------

1954

8/4

Spdg 7-29-54

8" @ 160

drlg. 1713

8/18

Spud 7-29-54


Oil well TD 2757'

8" @ 160 Miss. 2755 TD 2757

5" @ 2757 Comp. 40 BOPD

COMPLETED

J. G. McGEHEE

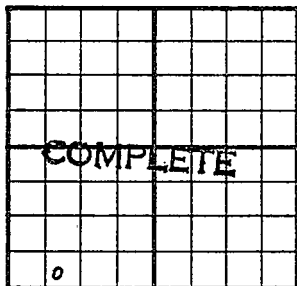County McPherson State KansasSec. 31 (Blk.
Twp.) 17 (Sur.
Rge.) 1W Map No. _____Operator B & R Drlg.Well No. 4 Farm CrumpackerElev. _____ Location SE SW SW330 Ft. From S Line SW990 Ft. From W Line Quarter1st. ReportCompletion AUG 18 1954Remarks Georob PoolShields - Contr.Spudding Date 7-29-54Drlg. Data Oil well TD 27578" @ 160 Miss. 2755 TD 2757 5" @ 2757Comp. 40 bopd

FABEN GILSTRAP