


KANSAS McPherson

FORM 51 IOM 12-46 PETROL

Section 31 Township 17 Range 1W

Well No. 1 Robinson

Company Westgate-Greenland

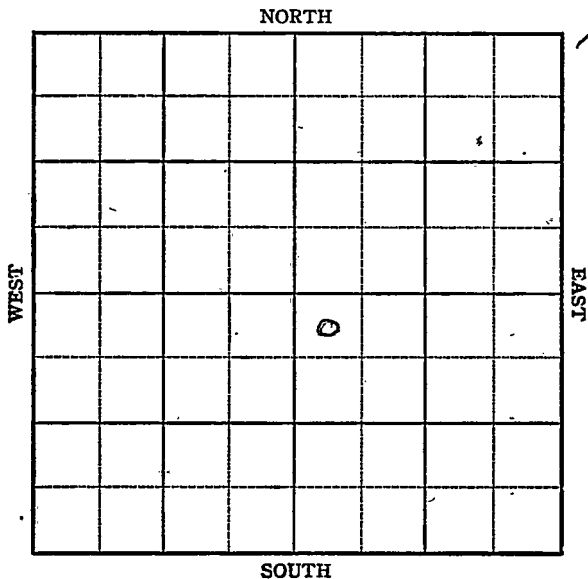

KANSAS

McPherson



Sec. 31 Twp. 17 R. 1-W

Well No. 1 Robinson Farm
Westgate-Greenland Company


330 Ft. from N. Line

_____ Ft. from S. Line

_____ Ft. from E. Line

330 Ft. from W. Line

NW SE

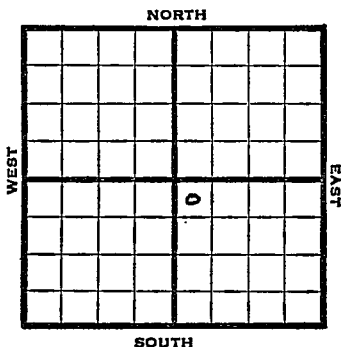

1947

REPORT

6/4

Lans. 2100
Chat 2665
5" @ 2665
TD 2670
1000' oil in 12 hrs.

6/11

Chat 2665'
5" @ 2665'
Pump 160 Pot
36.0 Gr.
TD 2673'

COMPLETED

Form 26 200 Bks. 10-46 Petrol
Kansas

Crowther Pool

Map No. _____ Sec. 31 Twp. 17 R. 1W

Well No. 1 Robinson

Westgate-Greenland

Company

FIRST REPORT

Contractor

NW SE


SECTION PLAT

330 Ft. from N. Line

_____ Ft. from S. Line

_____ Ft. from E. Line

330 Ft. from W. Line

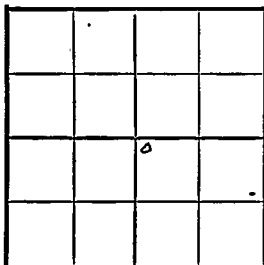

McPherson County

Location _____

Rig up _____

Drilling and Remarks:

Lans. 2100

Chat 2665

5" @ 2665

2670 TD

1000' oil in 12 hrs.

RECORD

Cased _____ in., _____ ft.

Sand _____

Gas _____

Oil _____

Total Depth _____

PRODUCTION

1st 24 hrs. Nat. _____

1st 24 hrs. after shot _____

Gas _____ Cu. Ft.

Dry Hole _____

Abandoned _____

Date

JUN 4 1947 19

S. J. LEWIS

Scout

Kansas

Crowther Pool

Map No. 42 Sec. 31 Twp. 17 R. 1WWell No. 1 RobinsonWestgate-Greenland et al. CompanyCOMPLETE Contractor

NW SE

SECTION PLAT

330 Ft. from N. Line Ft. from S. Line Ft. from E. Line330 Ft. from W. Line

		6	

McPherson CountyLocation Rig up

Drilling and Remarks:

*OK at 2665**5' @ 2665**Pump 160 Bbl**360 lbs*

RECORD

Cased in., ft.Sand Gas Oil Total Depth 2672

PRODUCTION

1st 24 hrs. Nat. 1st 24 hrs. after shot Gas Cu. Ft.Dry Hole Abandoned

Date

JUN 11 1947 19S. J. LEWIS

Scout