

KANSAS

McPherson County

FORM 51 10M 12-46 PETROL


Section 31 Township 17 Range 1-W

Well No. 2 Robinson

Company Mallard Drilg.

Crowther Pool NORTH

15

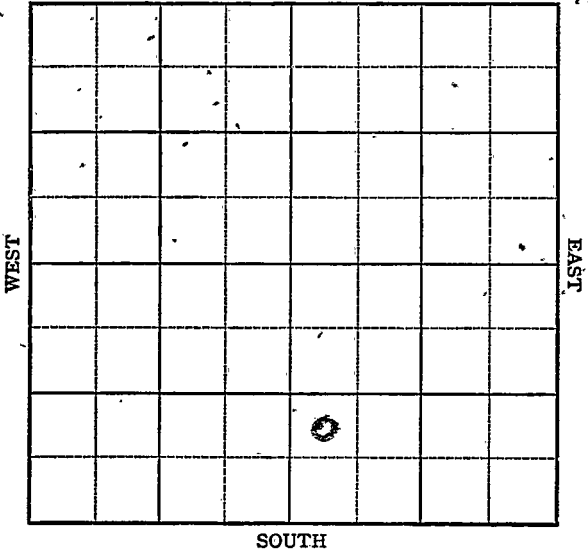

Sec. 31 Twp. 17 R. 1-W

Well No. #2 Robinson Farm

Mallard Drlg. Company


Crowther Pool

 Ft. from N. Line

990 Ft. from S. Line

 Ft. from E. Line

330 Ft. from W. Line

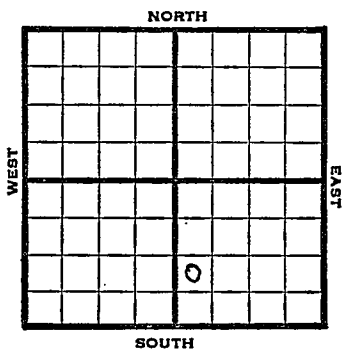

NW SW SE

1947 **Elev. 1352'** REPORT

7/2 8" @ 137'
Drlg 1700'

7/8 Mississippi 2732'
Drlg 2732'

7/16 ~~Miss~~ Mississippi 2732'
T.D. 2732'
Abandoned

ABANDONED

Map No. _____ Sec. 31 Twp. 17 R. 1W

Well No. 2 Robinson

Mallard Drlg. _____ Company

FIRST REPORT

Contractor

NW SW SE

SECTION PLAT

_____ Ft. from N. Line

990 _____ Ft. from S. Line

_____ Ft. from E. Line

330 _____ Ft. from W. Line

		0	

McPherson County

Location _____

Rig up _____

Drilling and Remarks:

8" @ 137
drlg. 1700

RECORD

Cased _____ in., _____ ft.

Sand _____

Gas _____

Oil _____

Total Depth _____

PRODUCTION

1st 24 hrs. Nat. _____

1st 24 hrs. after shot _____

Gas _____ Cu. Ft.

Dry Hole _____

Abandoned _____

Date

JUL 2 1947 19

S. J. LEWIS Scout

