




McPherson

FORM 51 IOM 12-46 PETROL

Section 31 - Township 17 Range 1W

Well No. 4 Robinson

Company Mallard Drlg.

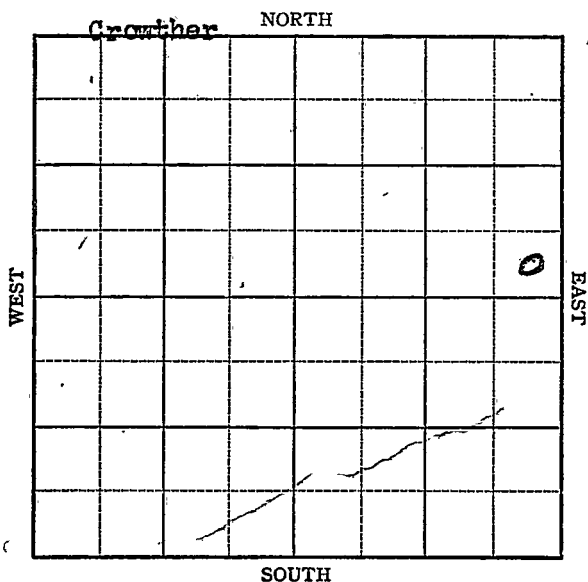

KANSAS

McPherson County

Sec. 31 Twp. 17 R. 1-W

Well No. 4 Robinson Farm

Mallard Drlg. Company

Crowther Pool


 Ft. from N. Line

330 Ft. from S. Line

330 Ft. from E. Line

 Ft. from W. Line

SE NE

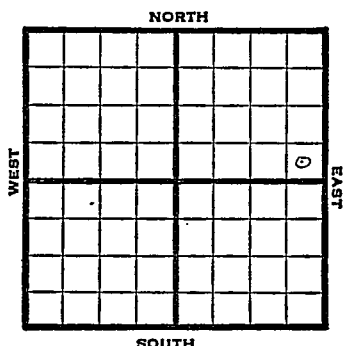

1947

Elev 1341' REPORT

7/30

RUR

8/6

8" @ 134'
Drlg 2385'

8/13

Chat 2656'
5" @ 2657'
TD 2673'
Pump 3 bbls. oil PH.

8/20

Chat 2656'
5" @ 2657'
Pump 116 Pot.
Gr. 38
TD 2678'
Complete

COMPLETED

Kansas

Map No. _____ Sec. 31 Twp. 17 R. 1WWell No. 4 RobinsonMallard Drilling

Company

FIRST REPORT

Contractor

SE NE

SECTION PLAT

_____ Ft. from N. Line

330 Ft. from S. Line330 Ft. from E. Line

_____ Ft. from W. Line

McPherson County

Location _____

Rig up _____

Drilling and Remarks:

R U R

RECORD

Cased _____ in., _____ ft.

Sand _____

Gas _____

Oil _____

Total Depth _____

PRODUCTION

1st 24 hrs. Nat. _____

1st 24 hrs. after shot _____

Gas _____ Cu. Ft.

Dry Hole _____

Abandoned _____

Date

JUL 30 1947

19

S. J. LEWIS

Scout

Map No. 42 Sec. 31 Twp. 17 R. 1W

Well No. 4 Robinson


Mallard Drlg. Company

COMPLETE

Contractor

SE NE

E11341
SECTION PLAT

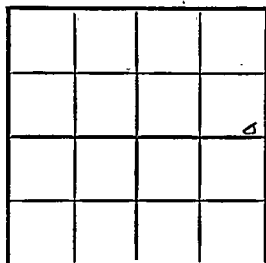

 Ft. from N. Line

330 Ft. from S. Line

330 Ft. from E. Line

 Ft. from W., Line

McPherson County

Location

Rig up

Drilling and Remarks:

Chay 2656

5' @ 2657

Prod 116 Pst

85° E

RECORD

Cased in., ft.

Sand

Gas

Oil

Total Depth 2629

PRODUCTION

1st 24 hrs. Nat.

1st 24 hrs. after shot

Gas Cu. Ft.

Dry Hole

Abandoned

Date

AUG 20 1947 19

S. J. LEWIS Scout