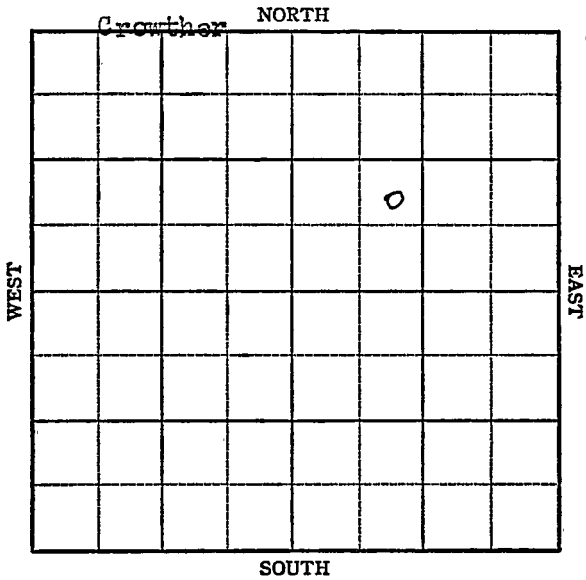


KANSASSection 31 Township 17 Range 1WWell No. 5 RobinsonCompany Mallard Drlg. et al

KANSAS McPherson
Sec. 31 Twp. 17 R. 1-W

Well No. 5 Robinson Farm
Mallard Drlg. etal Company

Crowther Pool


Ft. from N. Line

990 Ft. from S. Line

Ft. from E. Line

990 Ft. from W. Line

NE SW NE

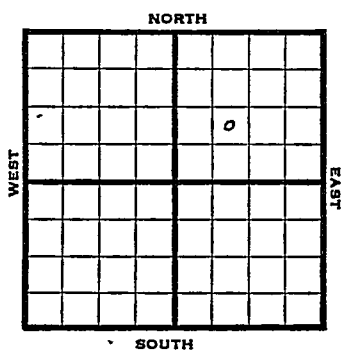

1947 Elev. 1338: REPORT

9/3	12" @ 133'
9/10	Lans. 2090' Mississippi 2654' TD 2657-5" @ 2654' RUST
9/17	Miss. 2654' 5" @ 2654' 1000 Acid Pump 600 Pot Gr. 36° Total Depth 2665' COMPLETED

Map No. _____ Sec. 31 Twp. 17 R. 1W

Well No. 5 Robinson

Mallard Drlg. etal.


Company

DRIST REPORT

Contractor

NE SW NE

SECTION PLAT

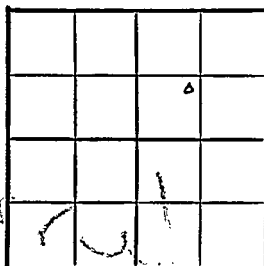

_____ Ft. from N. Line

990 Ft. from S. Line

_____ Ft. from E. Line

990 Ft. from W. Line

McPherson County

Location X

Rig up _____

Drilling and Remarks:

12" @ 133

RECORD

Cased _____ in., _____ ft.

Sand _____

Gas _____

Oil _____

Total Depth _____

PRODUCTION

1st 24 hrs. Nat. _____

1st 24 hrs. after shot _____

Gas _____ Cu. Ft.

Dry Hole _____

Abandoned _____

Date

SEP 3 1947 19

S. J. LEWIS Scout

Map No. 42 Sec. 31 Twp. 17 R. 1W

Well No. 5 Robinson


Mallard Drlg. etal. Company

COMPLETE

Contractor

NE SW NE

E1138
SECTION PLAT

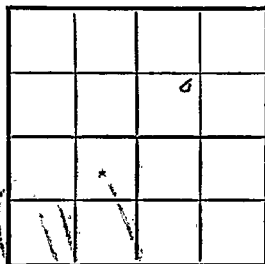

 Ft. from N. Line

990 Ft. from S. Line

 Ft. from E. Line

990 Ft. from W. Line

McPherson County

Location

Rig up

Drilling and Remarks:

*Miss 2654
5" @ 2654
1000 Acid
Pump 660 Bbl
860 Gr*

RECORD

Cased in., ft.

Sand

Gas

Oil

Total Depth 2665

PRODUCTION

1st 24 hrs. Nat.

1st 24 hrs. after shot

Gas Cu. Ft.

Dry Hole

Abandoned

Date

SEP 17 1947 19 S. I. LEWIS Scout