

KANSAS

FORM 51 10M 12-46 PETROL


McPherson

Section 31 Township 17 Range 1-W

Well No. 7 Robinson

Company Westgate-Greenland

Crowther Pool NORTH

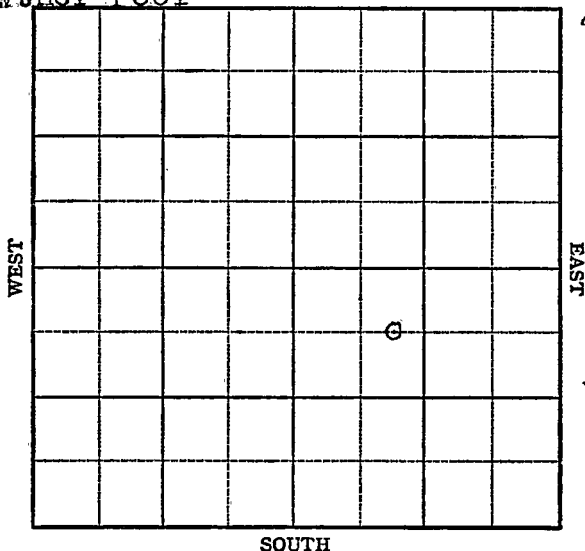

Sec. 31 Twp. 17 R. 1W

Well No. #7 Robinson Farm

Westgate-Greenland Company

Crowther


660 Ft. from N. Line

         Ft. from S. Line

         Ft. from E. Line

990 Ft. from W. Line

C E L NW SE

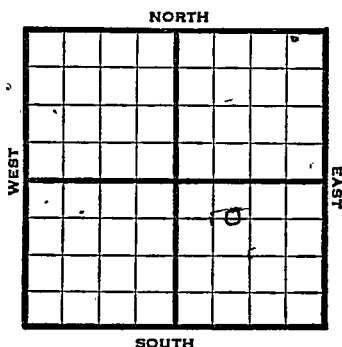

1947

REPORT

10/1 RUR

10/8 8" @ 135'  
Mississippi 2685  
TD 2688'  
5" @ 2686'  
RUST

10/15 TD 2698'  
1000' oil in 12 hrs.

10/22 Miss 2685'  
5" @ 2686'  
1000 Acid  
Depth Pot 3000  
Gr. 380  
Total Depth 2698'

**COMPLETED**

Map No. \_\_\_\_\_ Sec. 31 Twp. 17 R. 1W

Well No. 7 Robinson

Westgate-Greenland Company

**FIRST REPORT** Contractor

C E L NW SE

**SECTION PLAT**

660 Ft. from N. Line

\_\_\_\_\_ Ft. from S. Line

\_\_\_\_\_ Ft. from E. Line

990 Ft. from W. Line

|  |  |   |  |
|--|--|---|--|
|  |  |   |  |
|  |  |   |  |
|  |  | o |  |
|  |  |   |  |

McPherson County

Location \_\_\_\_\_

Rig up \_\_\_\_\_

Drilling and Remarks:

R U R

**RECORD**

Cased \_\_\_\_\_ in., \_\_\_\_\_ ft.

Sand \_\_\_\_\_

Gas \_\_\_\_\_

Oil \_\_\_\_\_

Total Depth \_\_\_\_\_

**PRODUCTION**

1st 24 hrs. Nat. \_\_\_\_\_

1st 24 hrs. after shot \_\_\_\_\_

Gas \_\_\_\_\_ Cu. Ft.

Dry Hole \_\_\_\_\_

Abandoned \_\_\_\_\_

Date

OCT 1 1947 19

S. J. LEWIS Scout

~~Kansas~~

Growther Pool

Map No. 42 Sec. 31 Twp. 17 R. 1WWell No. 7 RobinsonWestgate-Greenland CompanyCOMPLETE Contractor

C E L NW SE

## SECTION PLAT

660 Ft. from N. Line       Ft. from S. Line       Ft. from E. Line990 Ft. from W. Line

|  |  |   |  |
|--|--|---|--|
|  |  |   |  |
|  |  |   |  |
|  |  | o |  |
|  |  |   |  |

McPherson CountyLocation                     Rig up                     

Drilling and Remarks:

*Mar 2685*  
*5' @ 2686*  
*1000 acid*  
*Dep 700 ft 3000*  
*08 2/22*

## RECORD

Cased            in.,            ft.Sand                     Gas                     Oil                     Total Depth 2685

## PRODUCTION

1st 24 hrs. Nat.                     1st 24 hrs. after shot                     Gas                      Cu. Ft.Dry Hole                     Abandoned                     

Date

OCT 22 1947. 19S. J. LEWIS Scout