

Section 31 Township 17 Range 1W

Well No. #8 Robinson

Company Westgate-Greenland


Growther Pool

NORTH

2

WEST

EAST

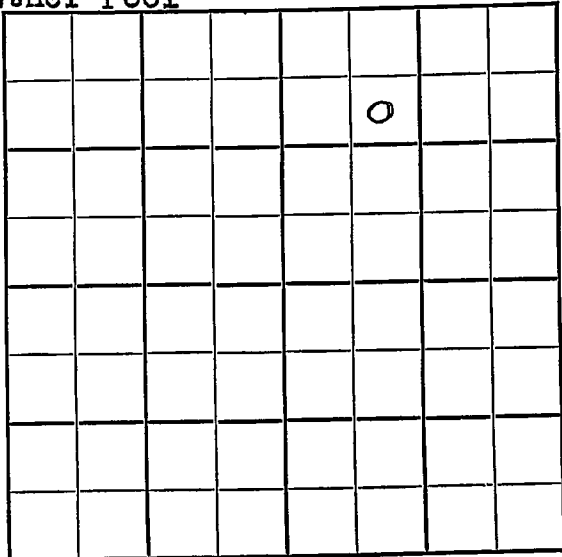

SOUTH

KANSAS

McPherson

Sec. 31

Twp. 17

R. 1-N

Well No. 8 Robinson

Farm

Westgate-Greenland

Company

Crowther


990 Ft. from N. Line

Ft. from S. Line

Ft. from E. Line

990 Ft. from W. Line

SE NW NE

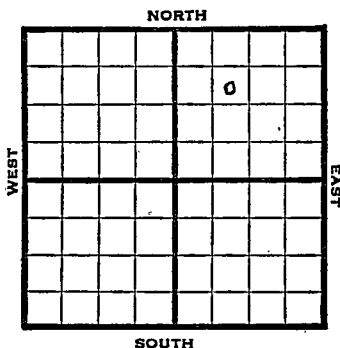

1947

Elev. 1339', REPORT

10/22

8" @ 134'  
Drlg. 2296'

11/5

Miss. 2653'  
5" @ 2654'  
1000 Acid  
Pump 495 oil & 5% W Pot  
Total Depth 2663'  
Gr. 36°

**COMPLETED**

Map No. \_\_\_\_\_ Sec. 31 Twp. 17 R. 1W

Well No. 8 Robinson

Westgate-Greenland Company

**FIRST REPORT** Contractor

SE NW NE

**SECTION PLAT**

990 Ft. from N. Line

		o	

\_\_\_\_\_ Ft. from S. Line

\_\_\_\_\_ Ft. from E. Line

990 Ft. from W. Line

McPherson County

Location \_\_\_\_\_

Rig up \_\_\_\_\_

Drilling and Remarks:

8" @ 134'

2296'

**RECORD**

Cased \_\_\_\_\_ in., \_\_\_\_\_ ft.

Sand \_\_\_\_\_

Gas \_\_\_\_\_

Oil \_\_\_\_\_

Total Depth \_\_\_\_\_

**PRODUCTION**

1st 24 hrs. Nat. \_\_\_\_\_

1st 24 hrs. after shot \_\_\_\_\_

Gas \_\_\_\_\_ Cu. Ft.

Dry Hole \_\_\_\_\_

Abandoned \_\_\_\_\_

Date

OCT 22 1947 19 \_\_\_\_\_ S. J. LEWIS Scout

Kansas

Map No. 42 Sec. 31 Twp. 17 R. 1WWell No. 8 RobinsonWestgate-Greenland CompanyCOMPLETE

Contractor

SE NW NE

E1,1339  
SECTION PLAT990 Ft. from N. Line

\_\_\_\_\_ Ft. from S. Line

\_\_\_\_\_ Ft. from E. Line

990 Ft. from W. Line

		o	

McPherson County

Location \_\_\_\_\_

Rig up \_\_\_\_\_

Drilling and Remarks:

*Miss 2603*  
*5' @ 265'*  
*1000 ccial*  
*Prop 495 oil 15'*  
*Pat*

*36° SW*

## RECORD

Cased \_\_\_\_\_ in., \_\_\_\_\_ ft.

Sand \_\_\_\_\_

Gas \_\_\_\_\_

Oil \_\_\_\_\_

Total Depth 2663

## PRODUCTION

1st 24 hrs. Nat. \_\_\_\_\_

1st 24 hrs. after shot \_\_\_\_\_

Gas \_\_\_\_\_ Cu. Ft.

Dry Hole \_\_\_\_\_

Abandoned \_\_\_\_\_

Date

NOV 5 1947 19S. J. LEWIS Scout