


Section 31 Township 17 Range 3W

Well No. #1 Weddle

Company Leben Oil & Trans-Era

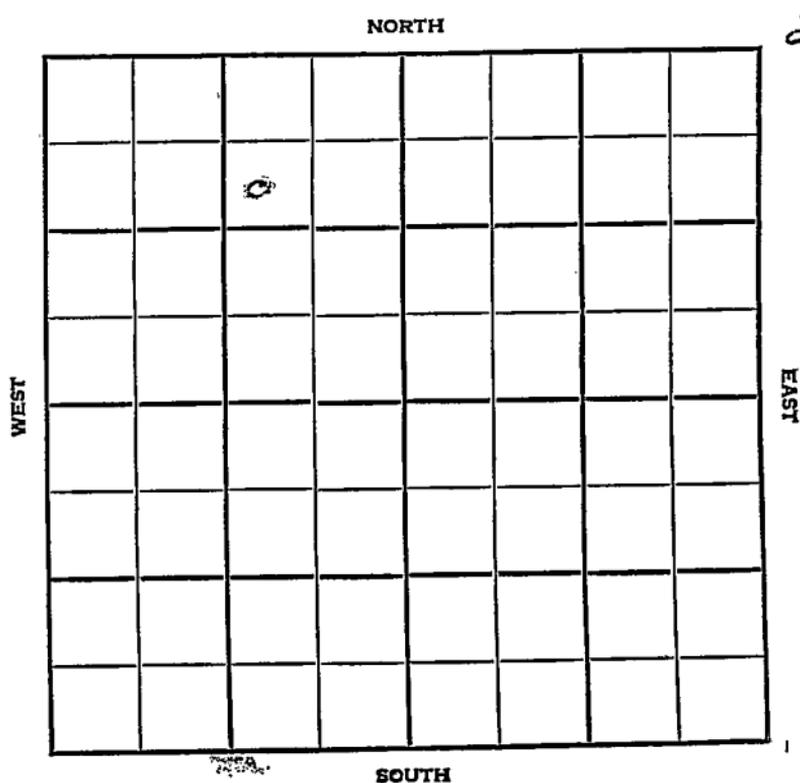

McPherson KANSAS

SEC.	TWP.	R.
31	17	3W

WELL NO. **I Weddle** FARM

COMPANY **Leben Oil & Trans-Era**


CONTRACTOR **Trans-Era**

990 _____ Ft. from N. Line

_____ Ft. from S. Line

990 _____ Ft. from E. Line

_____ Ft. from W. Line

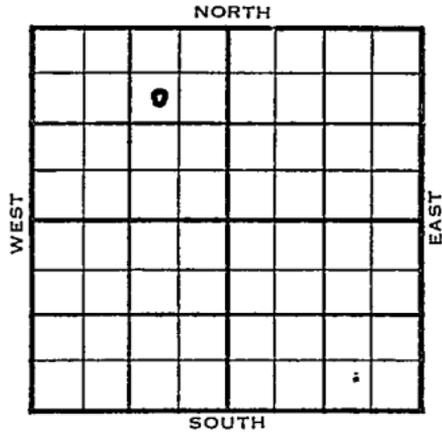


SW NE NW
Phillips FO

1955	ELEVATION	REPORT
------	-----------	--------

4/13	Spud 4-8-55 13" @ 152' D rlg. 1253'
------	---

County McPherson State Kansas
 Sec. 31 (Blk. 17 (Sur. 3W (Twp. 17 (Rge. 3W Map No.
 Operator Leben Oil & Trans-Era
 Well No. 1 Farm Weddle
 Elev. _____ Location SW NE NW

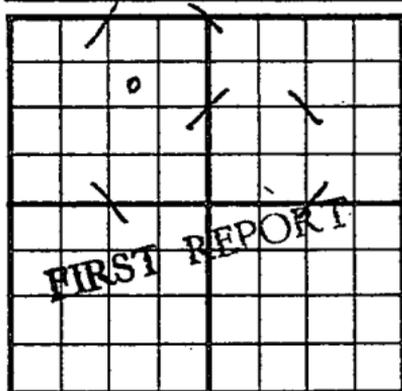

990 Ft. From N Line NW
990 Ft. From E Line Quarter
 Ist. Report APR 13 1955
 Completion _____
 Remarks Phillips farmout
Trans-Era - Contr.
 Spudding Date 4-8-55

Drlg. Data

13" @ 152 drlg. 1253

FABEN GILSTRAP