


Section 32 Township 17 Range 9W

Well No. 5 Oden

Company Mid-Plains etal

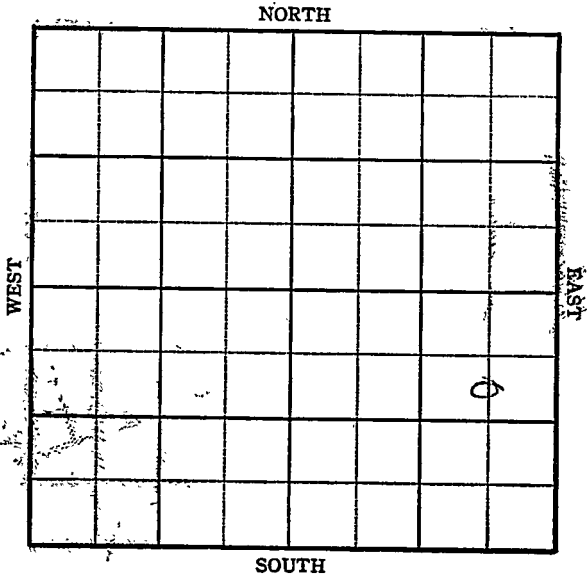

Sec. 32 Twp. 17 R. 9-W

Well No. #5 Oden Farm


Mid-Plains et al Company

990 Ft. from N. Line

_____ Ft. from S. Line

660 Ft. from E. Line

_____ Ft. from W. Line

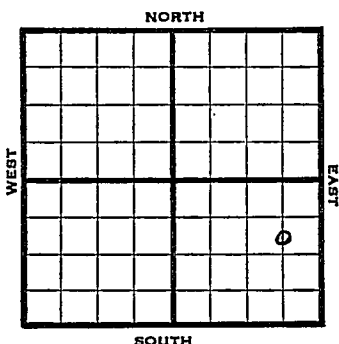

C S L NE SE

1945 Elev. 1759 REPORT

10/24	8" @ 216'					
	1545'					
10/31	Arb. 3223-3226					
	TD 3226					
	5" @ 3224 RUST					
11/7	" " "					
11/14	TD 3232					
	1300' oil plus 400' Wtr. in 18 hrs.					
11/21	" " " " " "					
11/28	" " " " " "					
12/5	" " " " " "					
12/12	" " " " " "					
12/19	Arb. 3223					
	5" @ 3224					
	TD 3232					
	Pump 60 oil plus 20% W. Pot.					
	Grav. 48.0					

COMPLETED

KANSAS

Kansas

Pool Name LorraineMap No. 45 Sec. 32 Twp. 17 R. 9WWell No. 5 OdenMid-Plains etal Company

FIRST REPORT

Contractor

C S L NE SE

SECTION PLAT

990 Ft. from N. Line Ft. from S. Line660 Ft. from E. Line Ft. from W. Line

			o

Ellsworth County

Location Rig 'up

Drilling and Remarks:

8"-216

1545

RECORD

Cased in., ft.Sand Gas Oil Total Depth

PRODUCTION

1st 24 hrs. Nat. 1st 24 hrs. after shot Gas Cu. Ft.Dry Hole Abandoned

Date

OCT 24 1945 19 S. J. LEWIS Scout

KANSAS

Kansas

Pool Name

Lorraine

Map No. *K-46*

Sec. 32

Twp. 17

R. 9^W

Well No. 5 Oden

Mid-Plains etal

Company

COMPLETED

Contractor

E. I. 1959

SECTION PLAT

C S L NE SE

990 Ft. from N. Line

Ft. from S. Line

660 Ft. from E. Line

Ft. from W. Line

Ellsworth County

Location

Rig up

Drilling and Remarks:

*Art 3223**5" @ 3224**Pump 60 oil + 20%
W.P.D.**H.C.S.*

RECORD

Cased _____ in., _____ ft.

Sand _____

Gas _____

Oil _____

Total Depth *3222*

PRODUCTION

1st 24 hrs. Nat. _____

1st 24 hrs. after shot _____

Gas _____ Cu. Ft.

Dry Hole _____

Abandoned _____

Date

DEC 1 9 1945

19

S. J. LEWIS

Scout