

Section 32 Township 17 Range 2W

Well No. #1 Malm

Company National Association

NORTH

WEST

EAST

SOUTH

16

Sec. 32 Twp. 17 R. 2W

Well No. #1 Malm Farm

National Association Company

K & E Contractor

Semi Wildcat


Ft. from N. Line

330 Ft. from S. Line

990 Ft. from E. Line

Ft. from W. Line


SW SE SE

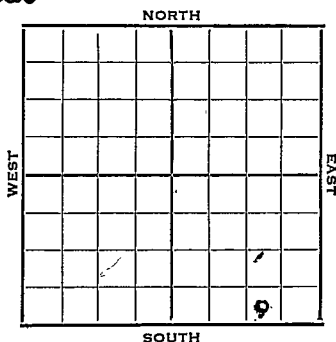

1952 Elev. 1481' REPORT

5/7 Spud 4-30-52
8" @ 160'
Drlg. 2200'
5/14 Drlg.
5/21 Spud 4-30-52
D&A TD 3658' 8" @ 160'
Lans. 2322 KC 2655
Miss. 2974 Kh 3175
Chatanooga 3200 Hunton 3298
Maq. sh 3344 Maq. dol. 3402
Viola 3468 Simp. 3556-70
Simp. dol. 3592-3606 Arb. 3610
TD 3658' D&A

ABANDONED

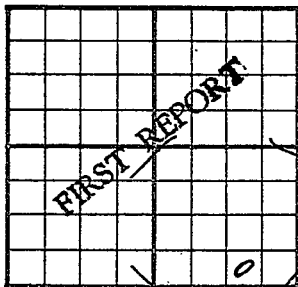County McPherson State KansasSec. 32 (Blk. Twp.) 17 (Sur. Rge.) 2W Map No.Operator National AssociationWell No. 1 Farm MainElev. 1481 Location SW SE SE350 Ft. From S Line SE990 Ft. From E Line Quarter1st. Report MAY 7 1952


Completion

Remarks

K & E - Contr.Spudding Date 4-30-52Drlg. Data Semi Wildcat8" @ 160 Drlg. 2200

J. G. McGEHEE

County McPherson State Kansas
 Sec. 32 (Blk. 17 (Sur. 2W Map No.)
 (Twp.) (Rge.)
 Operator National Assoc.
 Well No. 1 Farm Malm
 Elev. 1481 Location SW SE SE

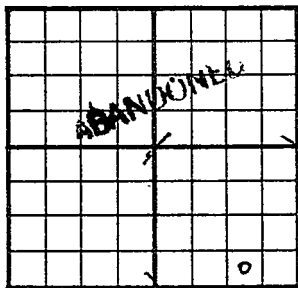

330 Ft. From S Line SE
990 Ft. From E Line Quarter
 Ist. Report
 Completion MAY 21 1952
 Remarks Semi Wildcat
K & E Drlg. - Contr.
 Spudding Date 4-30-52

Drlg. Data D & A TD 3658
8" @ 160 Lans. 2322 KC 2655
Miss. 2974 Kh. 3175 Chatanooga 3220
Hunton 3298 Maq. sh. 3344 Maq. dol. 3402
Viola 3468 Simp. 3556-70 Simp. dol.
3592-3606 Arb. 3610 TD 3658
D & A

J. G. McGEHEE