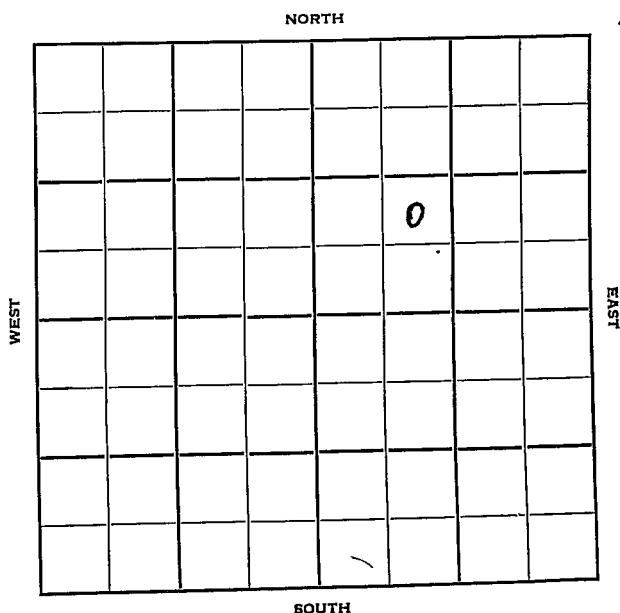


McPherson KANSAS

Section 22 Township 17 Range 1 WWell No. #1 BurchCompany Anschutz Drlg.

McPherson

KANSAS

Sec. 32 Twp. 17 R. 1W

Well No. #1 Burch Farm

Anschutz Drlg. Company

Honaker Contractor

Semi Wildcat


 Ft. from N. Line

990 Ft. from S. Line

 Ft. from E. Line

990 Ft. from W. Line

NE SW NE

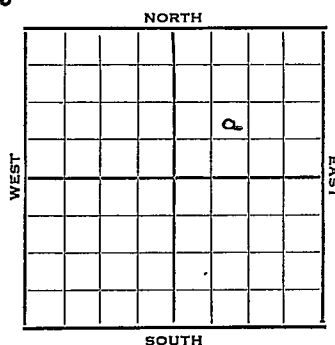


1952 Elev. 1329' REPORT

5/21 Spud 5-17-52
8" @ 164'
Drlg. 570'

5/28 Spud 5-17-52
D & A TD 2710'
8" @ 164' Doug 1905' Lans. 2086'
Miss 2652' TD 2710' D & A


ABANDONED

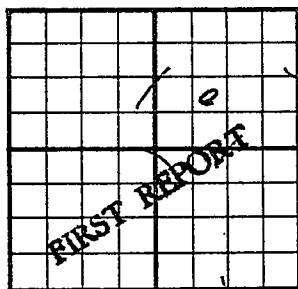County McPherson State KansasSec. 32 (Blk. Twp.) 17 (Sur. Rge.) 1W Map No.Operator Anschutz Drlg.Well No. 1 Farm BurchElev. Location NE SW NE990 Ft. From S Line NE990 Ft. From W Line Quarter1st. Report MAY 21 1952

Completion

Remarks

Honaker - Contr.Spudding Date 5-17-52Drlg. Data Semi Wildeat8" @ 164 Drlg. 570**J. G. McGEHEE**

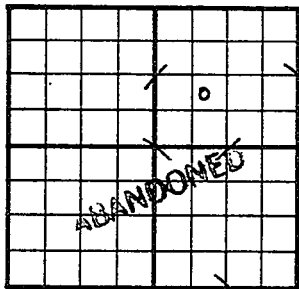County McPherson State KansasSec. 32 (Blk. Twp.) 17 (Sur. Rge.) 1W Map No.Operator Anschutz Drlg.Well No. 1 Farm BurchElev. 1329 Location NE SW NE

990 Ft. From S Line NE

990 Ft. From W Line Quarter

1st. Report

Completion MAY 28 1952Remarks Semi WildcatHonaker - Contr.Spudding Date 5-17-52Drlg. Data D & A TD 27108" @ 164 Doug. 1905 Lans. 2086Miss. 2652 TD 2710D & A

J. G. McGEHEE