

KANSAS

McPherson

Section 32 Township 17 Range 1W

Well No. 2 McCulle


Company Westgate-Greenland

Wildcat

NORTH

WEST

EAST

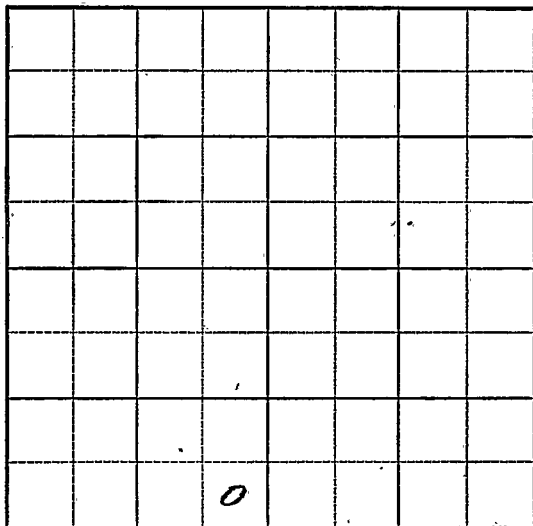

SOUTH

KANSAS

McPherson

Sec. 32 Twp. 17 R. 1W ✓

Well No. #2 McCulle Farm

Westgate-Greenland Company


Wildcat (Mallard Drlg., Cont^{mo} ^{North})

_____ Ft. from N. Line

330' Ft. from S. Line

330' Ft. from E. Line

_____ Ft. from W. Line

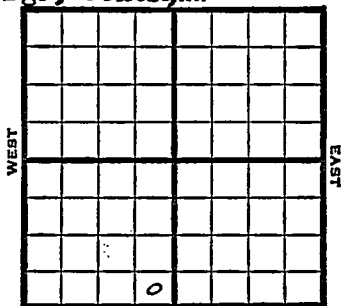

SE SW

1949 Elev. ^{1345 L+S} ~~3145~~ REPORT

7/13 8" @ 140'
Drlg. 2210'

7/20 Abandoned
Miss. 2664'
Viola 3150'
Simp. 3250'
Arb. 3297'
TD 3307'
ABANDONED

KANSAS

Wildcat

Map No. K47 Sec. 32 Twp. 17 R. 1W

Well No. 2 McColle

Westgate-Greenland Company

ABANDONED

Contractor

SE SW

E. 1345
SECTION PLAT

Ft. from N. Line

330 Ft. from S. Line

330 Ft. from E. Line

Ft. from W. Line

McPherson County

Location _____

Rig up _____

Drilling and Remarks:

Miss 2664
Vista 3150
Snip 3250
Cat 3297

RECORD

Cased _____ in, _____ ft.

Sand _____

Gas _____

Oil _____

Total Depth 2307

PRODUCTION

1st 24 hrs. Nat. _____

1st 24 hrs. after shot _____

Gas _____ Cu. Ft.

Dry-Hole _____

Abandoned _____

Date

JUL 20 1949 19

S. J. LEWIS

Scout