


KANSAS

Section 32 Township 17 Range 1W

Well No. 1 McColle

Company Mallard Drlg.

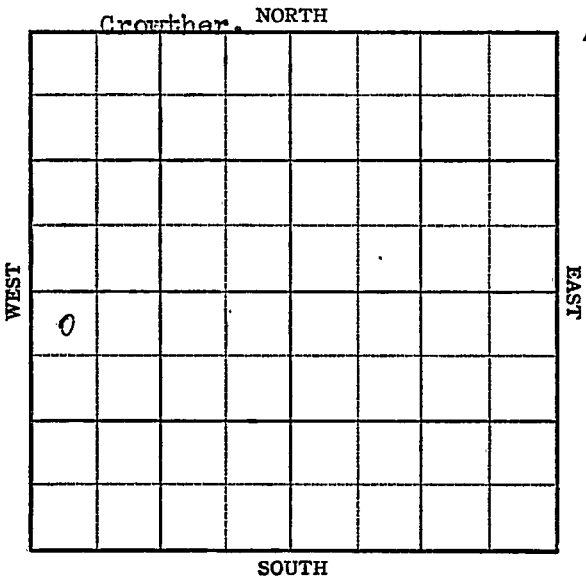

KANSAS McPherson

✓

Sec. 32 Twp. 17 R. 1W

Well No. #1 McColle Farm

Mallard Drlg. Company

Crowther


330 Ft. from N. Line

 Ft. from S. Line

 Ft. from E. Line

330 Ft. from W. Line

NW SW

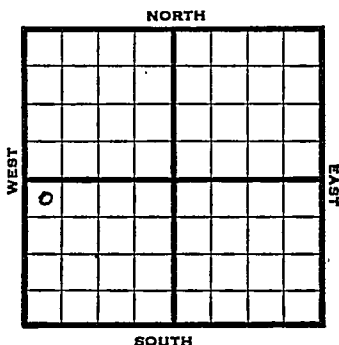

1947

Elev. 1331' REPORT

8/27

8" @ 136'
Drlg. 900'

9/3

Miss. 2673'
TD 2723'

ABANDONED

Map No. _____ Sec. 32 Twp. 17 R. 1W

Well No. 1 McColle

Mallard Drlg. Company

FIRST DEPT Contractor

NW SW

SECTION PLAT

330 Ft. from N. Line

_____ Ft. from S. Line

_____ Ft. from E. Line

330 Ft. from W. Line

6			

McPherson County

Location _____

Rig up _____

Drilling and Remarks:

8" @ 136

drlg. 900

RECORD

Cased _____ in., _____ ft.

Sand _____

Gas _____

Oil _____

Total Depth _____

PRODUCTION

1st 24 hrs. Nat. _____

1st 24 hrs. after shot _____

Gas _____ Cu. Ft.

Dry Hole _____

Abandoned _____

Date

AUG 27 1947 19 S. J. LEWIS Scout

Map No. 42 Sec. 32 Twp. 17 R. 1W

Well No. 1 McColle

Mallard Drlg. Company

ABANDONED

Contractor

NW SW

E1, 1831
SECTION PLAT

330 Ft. from N. Line

 Ft. from S. Line

 Ft. from E. Line

330 Ft. from W. Line

0			
1	2	3	

McPherson County

Location

Rig up

Drilling and Remarks:

Was 2673

RECORD

Cased in., ft.

Sand

Gas

Oil

Total Depth 2723

PRODUCTION

1st 24 hrs. Nat.

1st 24 hrs. after shot

Gas Cu. Ft.

Dry Hole

Abandoned

Date

SEP. 3 1947 19 S. J. LEWIS Scout