

# KANSAS


FORM 51 5M 6-46 PETROL

Ellsworth County

Section 33 Township 17 Range 9W

Well No. #3 Colberg

Company Derby Oil

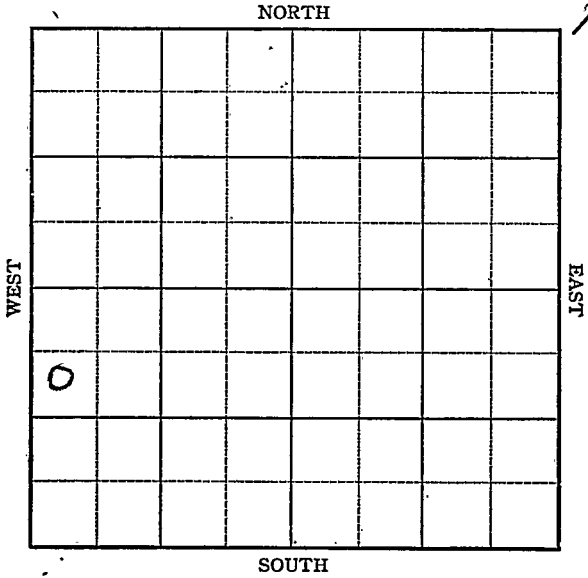

Sec. 33 Twp. 17 R. 9W

Well No. #3 Colberg Farm \_\_\_\_\_

Derby Oil Company \_\_\_\_\_

Lorraine


990 Ft. from N. Line

\_\_\_\_\_ Ft. from S. Line

\_\_\_\_\_ Ft. from E. Line

330 Ft. from W. Line

SW NW SW

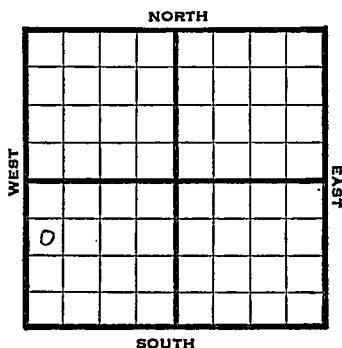

1946

Elev. 1758

REPORT

7/17 Location

7/23 8" @ 257' W<sup>0</sup>C

7/30 Drlg 2754'

8/7 Lans 3079  
Arb. 3233  
TD 3242'

ABANDONED

KANSAS Pool Name Lorraine  
 Map No. 45 Sec. 33 Twp. 17 R. 9W

Well No. 3 Colberg

Derby Oil Company

**FIRST REPORT** Contractor

SW NW SW

SECTION PLAT

990 Ft. from N. Line

\_\_\_\_\_ Ft. from S. Line

\_\_\_\_\_ Ft. from E. Line

330 Ft. from W. Line

o			

Ellsworth County

Location x

Rig up \_\_\_\_\_

Drilling and Remarks:

RECORD

Cased \_\_\_\_\_ in., \_\_\_\_\_ ft.

Sand \_\_\_\_\_

Gas \_\_\_\_\_

Oil \_\_\_\_\_

Total Depth \_\_\_\_\_

PRODUCTION

1st 24 hrs. Nat. \_\_\_\_\_

1st 24 hrs. after shot \_\_\_\_\_

Gas \_\_\_\_\_ Cu. Ft.

Dry Hole \_\_\_\_\_

Abandoned \_\_\_\_\_

Date

JUL 17 1946 19

S. J. LEWIS

Scout

KANSAS

KANSAS

Pool Name Lorraine Pool

Map No. 45 Sec. 33 Twp. 17 R. 9W

Well No. 3 Colberg

Derby Oil Company

**ABANDONED**

Contractor

SW NW SW

*E 1175*  
SECTION PLAT

990 Ft. from N. Line

\_\_\_\_\_ Ft. from S. Line

\_\_\_\_\_ Ft. from E. Line

330 Ft. from W. Line

0			

Ellsworth County

Location \_\_\_\_\_

Rig up \_\_\_\_\_

Drilling and Remarks:

*Lans 3079*

*227323*

**RECORD**

Cased \_\_\_\_\_ in., \_\_\_\_\_ ft.

Sand \_\_\_\_\_

Gas \_\_\_\_\_

Oil \_\_\_\_\_

Total Depth 3242

**PRODUCTION**

1st 24 hrs. Nat. \_\_\_\_\_

1st 24 hrs. after shot \_\_\_\_\_

Gas \_\_\_\_\_ Cu. Ft.

Dry Hole \_\_\_\_\_

Abandoned \_\_\_\_\_

Date

AUG 7 1946 19

S. J. LEWIS Scout