


KANSAS

Ellsworth

Section 33 Township 17 Range 9-W

Well No. #1 Kroesch

Company J C Dozier

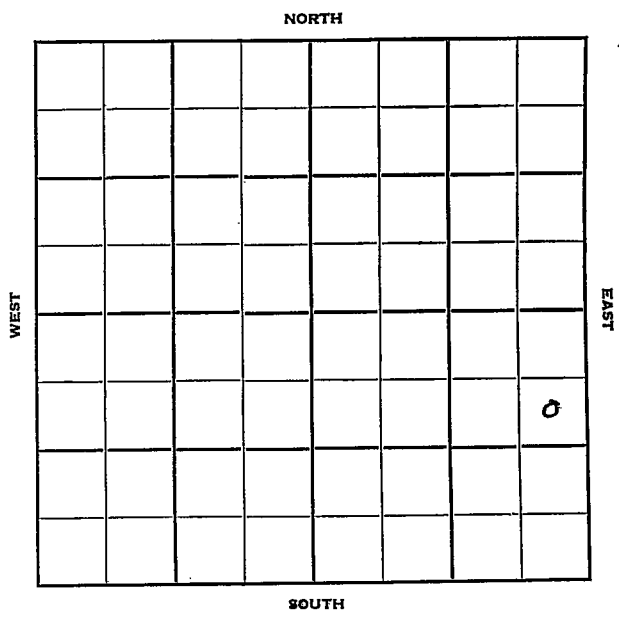

Sec. 33 Twp. 17 R. 9-W

Well No. # 1 Kröesch Farm

J C Dozier Company

Stagg Contractor


Wildcat
990 Ft. from N. Line

_____ Ft. from S. Line

330 Ft. from E. Line

_____ Ft. from W. Line

SE NE SE

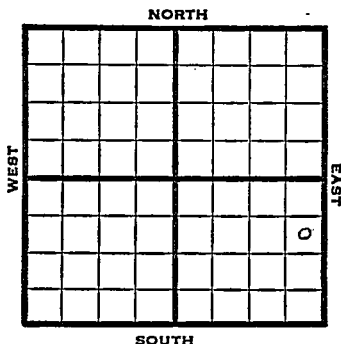

1950

Elev. 1751' REPORT

11/8

8" @ 159

11/22

D&A TD 3269'

8" @ 159

Heeb. 2733' Lans. 2878'

Arb. 3258' 3269 TD

D&A **ABANDONED**

