


Section 33 Township 17 Range 8-W

Well Number 1. *Buehler*
~~G. C. Holmes~~

Company Continental Oil

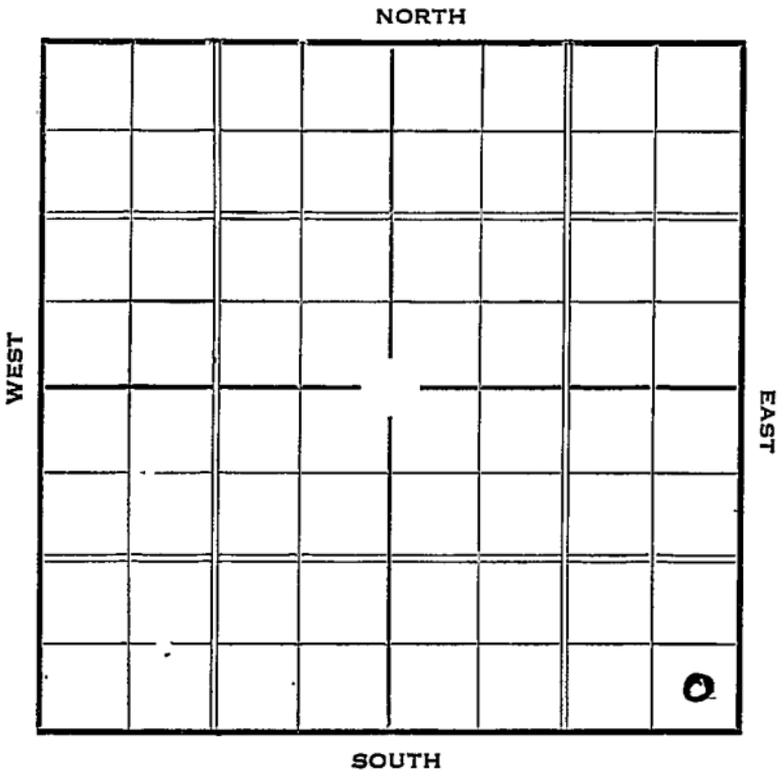

16

O. W. D. D

1937

4/28 Sil. 3272'.
T.D. 3288'.
P.B. 3281'.
1000 acid.
D & A

ABANDONED

1937

O. W. D. D

6/23 O.T.D. 3288'.
Deepen for salt water
Disposal.
7/2 " "
7/9 5" @ 3346'. T.D. 3357'. WOG.
7/16 Drlg. 3428'.
7/23 Drlg. 3600'.
7/30 Drlg. 3865'.
8/6 Drlg. 4147'.

8/11 5" @ 3346'.
T.D. 4277'.
Input of salt water.
780 bbls. per hr. by gravity.

ABANDONED

Form 26, I.M.D.S. 2-29 **KANSAS**

Map No. 45 Sec. 33 Twp. 17 R. SW

Well No. I. C. G. Holmes

Continental Oil Company

Contractor

SECTION PLAT

			o

_____ Ft. from N. Line

330 Ft. from S. Line

330 Ft. from E. Line

_____ Ft. from W. Line

FIRST REPORT

Location ✓

Rig up _____

Drilling and Remarks:



RECORD

Cased _____ in., _____ ft.

Sand _____

Gas _____

Oil _____

Total Depth _____

PRODUCTION

1st 24 hrs. Nat. _____

1st 24 hrs. after shot _____

Gas _____ Cu. Ft.

Dry Hole _____

Abandoned _____

Date

JAN 27 1937 19

S. J. LEWIS Scout

[Handwritten signature]

.....

6

Map No. 45 Sec. 33 Twp. 17 R. 8WWell No. 1 H BuchlerContinental Company

Contractor

SECTION PLAT

			0

_____ Ft. from N. Line

330 Ft. from S. Line230 Ft. from E. Line

_____ Ft. from W. Line

CORRECTION

Location _____

Rig up _____

Drilling and Remarks:

*They have changed
the farm name
from Holmes
to H. Buchler*

RECORD

Cased _____ in., _____ ft.

Sand _____

Gas _____

Oil _____

Total Depth _____

PRODUCTION

1st 24 hrs. Nat. _____

1st 24 hrs. after shot _____

Gas _____ Cu. Ft.

Dry Hole _____

Abandoned _____

Date

MAR 17 1937 19

S. J. LEWIS Scout

Paul

Returned _____

Cards _____

Tracing _____

France Map _____

Scarborough Map _____

Moody Map _____

Scarborough Plat Book _____

Moody Plat Book _____

KANSAS Ellsworth

Map No. _____ Sec. 33 Twp. 17 R. SW

Well No. 1 - Buckler

Continental Company

Contractor

ABANDONED

SECTION PLAT

			0

_____ Ft. from N. Line

330 Ft. from S. Line

330 Ft. from E. Line

_____ Ft. from W. Line

Location _____

Rig up _____

Drilling and Remarks:

P.B. 3281

1000 Acid

D & A

RECORD

Cased _____ in., _____ ft.

Sand Sil - 3272

Gas _____

Oil _____

Total Depth 3288

PRODUCTION

1st 24 hrs. Nat. _____

1st 24 hrs. after shot _____

Gas _____ Cu. Ft.

Dry Hole _____

Abandoned _____

Date APR 28 1937

19

H. Hatfield Scout

11

Ray

Returned	
Cards	Paul
Tracing	Joe
France Map	
Scarborough Map	
Moody Map	
Scarborough Plat Book	
Moody Plat Book	

KANSAS

Ellsworth

Map No. 45 Sec. 33 Twp. 17 R. 8 W

Well No. 1 - Buehler

Continental etal Company

Contractor

FIRST REPORT

SECTION PLAT

Ft. from N. Line
330 Ft. from S. Line
330 Ft. from E. Line
Ft. from W. Line


OWDD

Location

Rig up

Drilling and Remarks:

O.T.O. 3288

Deepen For saltwater Disposal

RECORD

Cased in., ft.
Sand
Gas
Oil
Total Depth

PRODUCTION

1st 24 hrs. Nat.
1st 24 hrs. after shot
Gas Cu. Ft.
Dry Hole
Abandoned

Date

JUN 23 1937 19

H. D. Hatfield Scout

✓
RAY

✓

✓

Returned
Cards
Tracing
France Map
Scarborough Map
Moody Map
Scarborough Flat Book
Moody Flat Book

RAY

KANSAS Ellsworth

Map No. 45 Sec. 33 Twp. 17 R. 8^w

Well No. 1 - Buehler

Continental etal Company

Contractor

ABANDONED

~~COMPLETED~~

SECTION PLAT

			2

_____ Ft. from N. Line

330 Ft. from S. Line

330 Ft. from E. Line

_____ Ft. from W. Line

OWDD - SWD

Location _____

Rig up _____

Drilling and Remarks:

OT.O. 3288

input of salt water

780 bbls p.H.

by gravity

RECORD

Cased 5 in., 3346 ft.

Sand _____

Gas _____

Oil _____

Total Depth 4277

PRODUCTION

1st 24 hrs. Nat. _____

1st 24 hrs. after shot _____

Gas _____ Cu. Ft.

Dry Hole _____

Abandoned 4277

Date

AUG 11 1937 19

H. D. Hatfield

Scout

map

Returned	
Cards	<i>[Signature]</i>
Tracing	<i>[Signature]</i>
France Map	<i>[Signature]</i>
Scarborough Map	<i>[Signature]</i>
Moody Map	<i>[Signature]</i>
Scarborough Plat Book	
Moody Plat Book	