


Section 33 Township 17 Range 8W

Well No. 11 Buehler

Company Continental oil

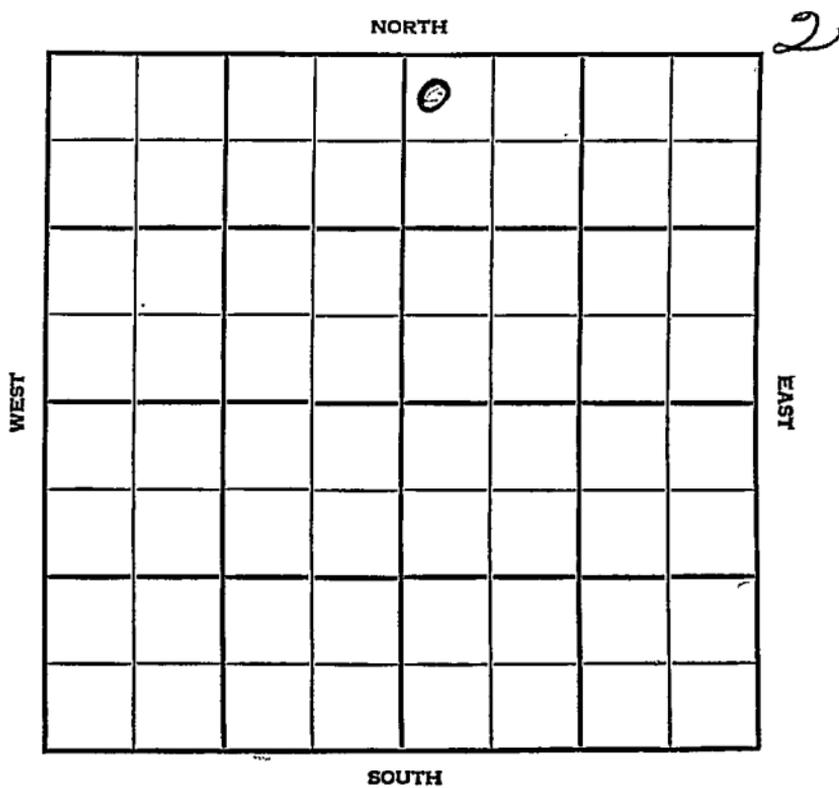

Ellsworth

KANSAS

SEC. 33	TWP. 17	R.. 8W
------------	------------	-----------

WELL NO.

#11 Buehler

FARM

COMPANY

Continental Oil

CONTRACTOR

L & J

Geneseo-Edwards


390' Ft. from N. Line

Ft. from S. Line

2250' Ft. from E. Line

Ft. from W. Line

NW NW NE

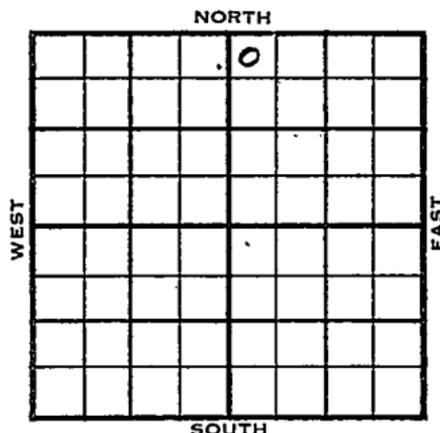

1955

ELEVATION

1774'

REPORT

7/6

Comm 7-3-55  
8" @ 209/150 Drlg. 1235

8/3

Comm 7-3-55  
 H 2684  
 L 2827  
 C 3142  
 A 3194 3192  
 TD 3205  
 8" @ 209/150 5 1/2" @ 3203/150  
 CO to 3199 21/3191-98 B/3/4 bo  
 3 hr 500 A S/105 bo 4 hr  
 P/18 bo 8 hr P/45 bo 8 hr  
 Comp 90 bopd

COMPLETED

County Ellsworth Elev. \_\_\_\_\_  
 Sec. 33 Twp. 17 Rge. 8W  
 Company Continental Oil  
 Farm Name Buehler No. 11

TOPS	DEPTH	LOG	DATUM
Anh.			
Tp.			
H.			
Tr.			
Dg.			
Bl.			
L.			
K.C.			
B.K.C.			
Ce.			
C.			
M.			
M.			
K.			
Mz.			
Mo.			
V.			
S.			
S.			
A.			
R.			
PE.			
G.			
T.R.			

Loc. in Sec.

NW NW NE

390' NL

2250' EL

Geol.

Contr.

L & J

Pool

Genesee-Edwards

FIRST REPORT

JUL 8 '55

Date Comm. 7-3-55

8" @ 209/150 drlg. 1235

Co.

Lse.

No.

Sec.

T.

R.

County Ellsworth Elev. 1774  
 Sec. 33 Twp. 17 Rge. 8W  
 Company Continental Oil  
 Farm Name Buehler No. 11

TOPS	DEPTH	LOG	DATUM
Anh.			
TP.			
H.		2684	910
Tr.			
Dg.			
BL.			
L.		2822	1048
K.C.			
B.K.C.			
Ce.			
C.	3142		1368
M.			
M.			
K.			
Mz.			
Me.			
V.			
S.			
S.			
A.	3194	3192	1418
R.			
PE.			
G.			
T.D.	3205		

Loc. in Sec.

NW NW NE

390' NL

2250' EL

Geol.

Contr.

I & J

Pool

Geneseo-Edwards

		0	

**COMPLETE**

Date Comm. 7-3-55 AUG 3 1955

8" @ 209/150 5 1/2" @ 3203/150

CO to 3199 21/ 3191-98 B/ 3/4 bo

3 hr. 500 A S/ 105 bo 4 hr.

P/ 18 bo 8 hr. Ø/ 45 bo 8 hr.

Comp. 90 bopd

Co.  
Loc.  
No.  
Sec.  
T.  
R.