


Section 33 Township 17 Range 8-W

Well No. #3 H. Buehler

Company Continental et al

NORTH **Edwards Pool**

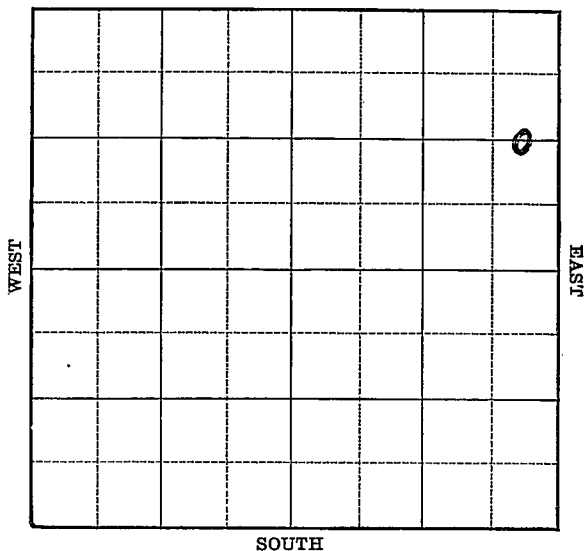



KANSAS *Ellsworth*Map No. *45* Sec. *33* Twp. *17* R. *8W*Well No. *3 H. Buckler**Continental & Co.* Company

Contractor

*CELNE*

## FIRST REPORT

## SECTION PLAT

*1320* Ft. from N. Line

\_\_\_\_\_ Ft. from S. Line

*330* Ft. from E. Line

\_\_\_\_\_ Ft. from W. Line

			0

*Edwards Pool*

Location \_\_\_\_\_

Rig up \_\_\_\_\_

Drilling and Remarks:

*Rotary*

## RECORD

Cased \_\_\_\_\_ in., \_\_\_\_\_ ft.

Sand \_\_\_\_\_

Gas \_\_\_\_\_

Oil \_\_\_\_\_

Total Depth \_\_\_\_\_

## PRODUCTION

1st 24 hrs. Nat. \_\_\_\_\_

1st 24 hrs. after shot \_\_\_\_\_

Gas \_\_\_\_\_ Cu. Ft.

Dry Hole \_\_\_\_\_

Abandoned \_\_\_\_\_

Date

AUG 30 1939 19

S. J. LEWIS Scout

Map No. 45 Sec. 33 Twp. 17 R. 8WWell No. 3 H. BuehlerContinental

Company

Contractor

COMPLETED

C E L N E

1320 Ft. from N. Line

\_\_\_\_\_ Ft. from S. Line

330 Ft. from E. Line

\_\_\_\_\_ Ft. from W. Line

EDWARDS POOL

## SECTION PLAT

			o

Location \_\_\_\_\_

Rig up \_\_\_\_\_

Drilling and Remarks:

*CR 8 3180**6" @ 3181**2000 @ acid**Pump 2001 P & X*

## RECORD

Cased \_\_\_\_\_ in., \_\_\_\_\_ ft.

Sand \_\_\_\_\_

Gas \_\_\_\_\_

Oil \_\_\_\_\_

Total Depth 3222.

## PRODUCTION

1st 24 hrs. Nat. \_\_\_\_\_

1st 24 hrs. after shot \_\_\_\_\_

Gas \_\_\_\_\_ Cu. Ft.

Dry Hole \_\_\_\_\_

Abandoned \_\_\_\_\_

Date

SEP 27 1939 19

S. J. LEWIS Scout