

KANSAS


Ellsworth

Form 51-5M-7-39-Palace

Section 33 Township 17 Range 8-W

Well No. #4 H. Buehler

Company Continental et al

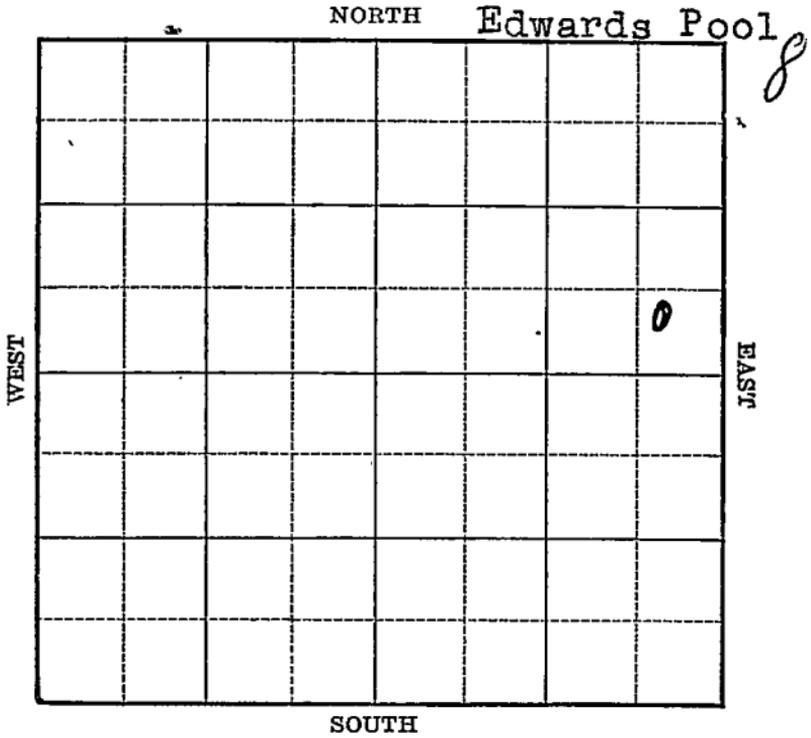

Sec. 33 Twp. 17 R. 8-W

Well No. #4 H. Buehler Farm

Continental et al Company


(Edwards)

_____ Ft. from N. Line

440 Ft. from S. Line

440 Ft. from E. Line

_____ Ft. from W. Line

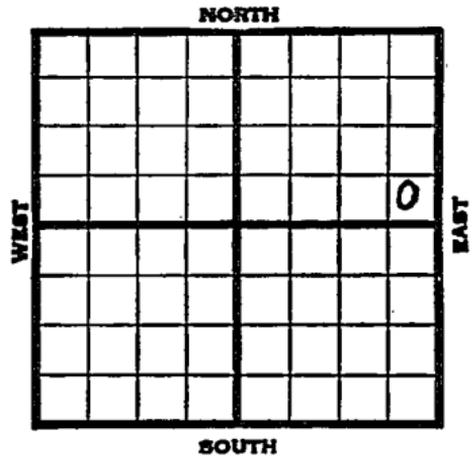

Elev. 1771

1940	REPORT
1/24	Location
2/1	10" - 216' WOC.
2/8	SD 2075'
2/15	Drlg. 3195'
2/23	Arb. 3192' 7" - 3193'
	T.D. 3225' 800' oil.
2/28	Arb. 3192'
	7" - 3193'
	T.D. 3225'
	9000 acid.
	Potential 862 bbls., pump.
	COMPLETED

Map No. 45 Sec. 33 Twp. 17 R. 8W

Well No. 4 H. Buehler

Continental etal Company

Contractor

SECTION PLAT

SE NE

_____ Ft. from N. Line

440 Ft. from S. Line

440 Ft. from E. Line

_____ Ft. from W. Line

			D

EDWARDS POOL

Location X

Rig up _____

Drilling and Remarks:

RECORD

Cased _____ in., _____ ft.

Sand _____

Gas _____

Oil _____

Total Depth _____

PRODUCTION

1st 24 hrs. Nat. _____

1st 24 hrs. after shot _____

Gas _____ Cu. Ft.

Dry Hole _____

Abandoned _____

Date

JAN 24 1940 19

S. I. LEWIS

Scout

Map No. 45 Sec. 33 Twp. 17 R. 8WWell No. 4 H. Buehler
Continental etal _____ Company

Contractor _____

COMPLETED

SE NE

SECTION PLAT

_____ Ft. from N. Line

440 Ft. from S. Line440 Ft. from E. Line

_____ Ft. from W. Line

EDWARDS POOL

			0

Location _____

Rig up _____

Drilling and Remarks:

On 83192
7" @ 3193.
9000 accl.
Pump 162 P.S.T.

RECORD

Cased _____ in., _____ ft.

Sand _____

Gas _____

Oil _____

Total Depth 3225**PRODUCTION**

1st 24 hrs. Nat. _____

1st 24 hrs. after shot _____

Gas _____ Cu. Ft.

Dry Hole _____

Abandoned _____

Date

FEB 28 1940 19S. J. LEWIS

Scout