

KANSAS


Ellsworth

FORM 51 5M PETROL

Section 33 Township 17 Range 8W

Well No. 10 Buehler

Company Continental

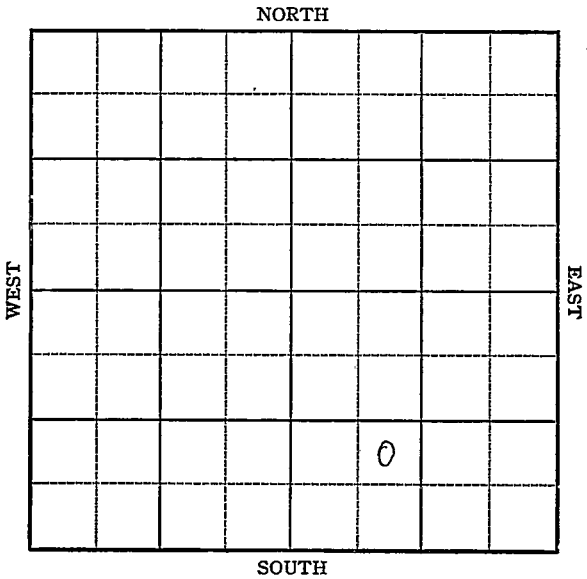

KANSAS

Ellsworth

Sec. 33 Twp. 17 S R. 8 W

Well No. #10 Buehler Farm

CONTINENTAL Company


Geneseo

\_\_\_\_\_ Ft. from N. Line

990' Ft. from S. Line

\_\_\_\_\_ Ft. from E. Line

990' Ft. from W. Line

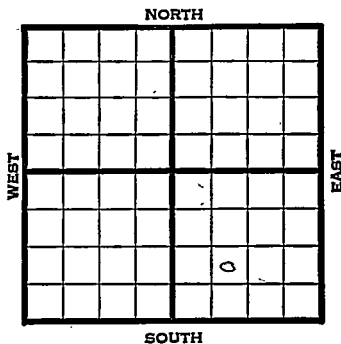

NE SW SE Elev. 1767

REPORT

1945

<p>4-18 4/27 5/3 5/10 5/17 5/24 5/31 6/8 6/27</p>	<p>Location Derrick " " " " RUR 10" @ 246 Drlg. 2155 Arb. 3428 7" @ 3614 4000 acid. TD 3838 Input 400 W PH SWD</p>
---	--

**ABANDONED**

Kansas Pool Name GeneseoMap No. 45 Sec. 33 Twp. 17 R. 8WWell No. 10 BuehlerContinental CompanyFIRST REPORT Contractor

NE SW SE

## SECTION PLAT


           Ft. from N. Line990 Ft. from S. Line           Ft. from E. Line990 Ft. from W. LineElsworthLocation XRig up           

Drilling and Remarks:

## RECORD

Cased            in.,            ft.Sand           Gas           Oil           Total Depth           

## PRODUCTION

1st 24 hrs. Nat.           1st 24 hrs. after shot           Gas            Cu. Ft.Dry Hole           Abandoned           

Date

APR 18 1945

19

S. J. LEWIS Scout

