

KANSAS


FORM 51 5M BR1X

Ellsworth

Section 23 Township 17 Range 8W

Well No. #9 H Buehler

Company Continental et al

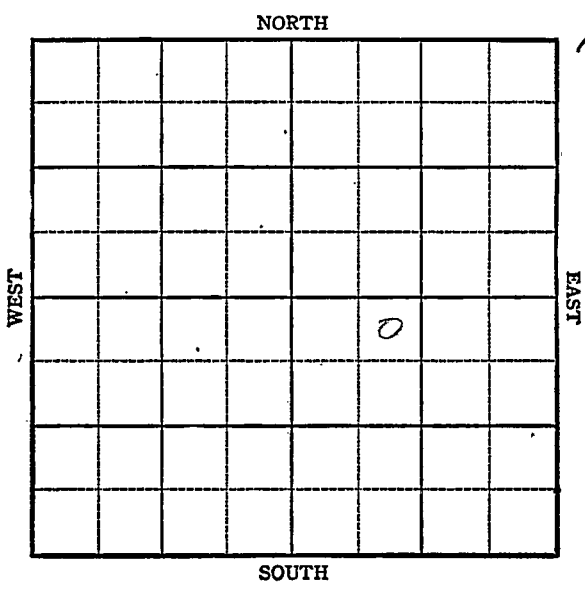

KANSAS

Ellsworth County

Sec. 33 Twp. 17 R. 8W

Well No. #9 H. Buehler Farm

Continental etal Company

Geneseo


330 Ft. from N. Line

 Ft. from S. Line

 Ft. from E. Line

990 Ft. from W. Line

NE NW SE Elm. 1766

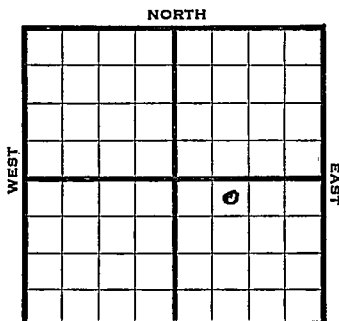

1944

R E P O R T

8/16	Drk.
8/23	10" @ 202 WOO
8/30	Drlg. 2817
9/8	Arb 3219-44 TD
9/13	7" @ 3243 RUST
9/21	" " " "
9/27	PB 3239
	48 shots 3220-27 1000 acid swb 8 oil
	per hr. 8 hrs. 2000 acid
	Arb 3219
	7" @ 3243
	PB 3239
	48 shots 3220-27
	3000 acid
	Pump 355 oil plus 13% wtr Pot.
	Grav. 39.
	TD 3244

COMPLETED

Pool Name GeneseeMap No. KANSAS Sec. 33 Twp. 17 R. 8WWell No. 9 H. BuehlerContinental et al Company

FIRST REPORT

NE NW SE Contractor

SECTION PLAT

		P	

330 Ft. from N. Line Ft. from S. Line Ft. from E. Line990 Ft. from W. Line

Ellsworth

Location Rig up

Drilling and Remarks:

Derrick

RECORD

Cased in., ft.Sand Gas Oil Total Depth

PRODUCTION

1st 24 hrs. Nat. 1st 24 hrs. after shot Gas Cu. Ft.Dry Hole Abandoned

Date

AUG 16 1944 19S. J. LEWIS Scout

Pool Name GeneseeMap No. KANSAS Sec. 33 Twp. 17 R. 8WWell No. 9 H. BuehlerContinental et al. CompanyCOMPLETED

Contractor

NE NW SE

SECTION PLAT

		0	

330 Ft. from N. Line

Ft. from S. Line

Ft. from E. Line

990 Ft. from W. LineEllsworth County

Location

Rig up

Drilling and Remarks:

Cr 32197" @ 3248PS 328945 lbs to 3220-273000 acis 6Pump 3055 oil + 13% waterOct. 3250

RECORD

Cased _____ in., _____ ft.

Sand _____

Gas _____

Oil _____

Total Depth 3244

PRODUCTION

1st 24 hrs. Nat. _____

1st 24 hrs. after shot _____

Gas _____ Cu. Ft.

Waters
Dry Hole _____

Abandoned _____

Date

SEP 27 1944 19

S. J. LEWIS Scout