

KANSAS

Form 51-5M-7-40-Palace

Ellsworth

Section 33 Township 17 Range 8-W

Well No. 6 Buhler

Company Continental et al

Geneseo Pool

NORTH

							0 /

WEST

EAST

SOUTH

Sec. 33 Twp. 17 R. 8-W

Well No. #6 Buhler Farm _____

Continental et al Company _____

(Geneseo)


400 Ft. from N. Line

_____ Ft. from S. Line

400 Ft. from E. Line

_____ Ft. from W. Line

Elev. 1767

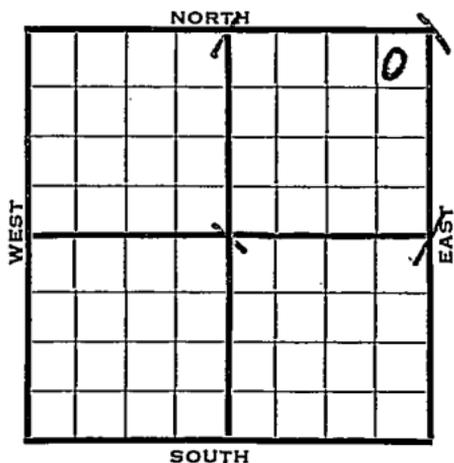

1941	REPORT
1/29	Derrick.
2/6	"
2/13	10" - 215' Drlg. 2535'
2/20	Arb. 3159-63' T.D. 6" - 3160'
	RUST.
2/27	T.D. 3216' Swab 226 oil 4
	hours.
3/5	Arb. 3159'
	6" - 3160'
	T.D. 3216'
	Echometer potential 9143 bbls.
	Maximum 3000 bbls.
	40.1 Gravity
	COMPLETED

Map No. 95 Sec. 33 Twp. 17 R. 8WWell No. 6 BuhlerContinental etal Company

Contractor

COMPLETED**SECTION PLAT**

NE/C

400 Ft. from N. Line Ft. from S. Line400 Ft. from E. Line Ft. from W. Line

GENESEO POOL

			o

Location _____

Rig up _____

Drilling and Remarks:

*Ce 82159**6" @ 3160**Echo Pa 8.9143**Max 3000**40' Gr***RECORD**

Cased _____ in., _____ ft.

Sand _____

Gas _____

Oil _____

Total Depth 3216**PRODUCTION**

1st 24 hrs. Nat. _____

1st 24 hrs. after shot _____

Gas _____ Cu. Ft.

Dry Hole _____

Abandoned _____

Date

MAR 5 1941 19

S. J. LEWIS Scout