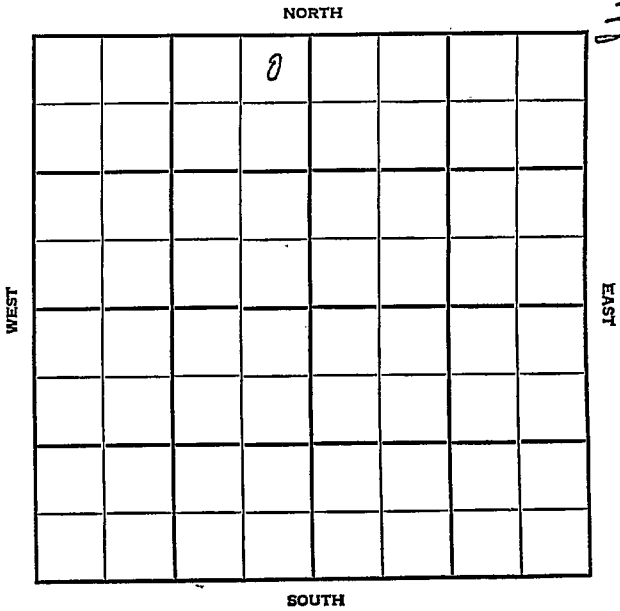


Section 33 Township 17 Range 8WWell No. #1 KunkleCompany Lebsack et al

Ellsworth

KANSAS

SEC.	TWP.	R.
33	17	8W

WELL NO.

#1 Kunkle

FARM

COMPANY

Lebsack et al

CONTRACTOR

Isern

Geneseo-Edwards Pool

330 Ft. from N. Line

Ft. from S. Line

330 Ft. from E. Line

Ft. from W. Line

			0			

WEST

EAST

SOUTH

NE NE NW

ELEVATION

REPORT

1955

1781'

3/23

M I R

6/1

Comm 3-23-55

Anh 554, H 2711, L. 2852, Cong sd
3199, Cong 3224, S 3260, A 3281,
TD 3288

8 5/8" @ 270/175 DST 3273-81 open
1 hr Rec 10' ocm 990/20" DST 3282-88
open 2 hr, Rec 150' gas 150' hoem
1035/20" TD 3288 5 1/2" @ 3282/100
CO to 3288 250 A S/13 boph 6 hr
Comp 40 bopd

COMPLETED

County Ellsworth Elev. 1781
 Sec. 33 Twp. 17 Rge. 8W
 Company Lebsack et al.
 Farm Name Kunkle No. 1

TOPS	DEPTH	LOG	DATUM
Anh.	<u>554</u>		
Tr.			
H.	<u>2711</u>		<u>930</u>
Tr.			
Dg.			
Bl.			
L.	<u>2852</u>		<u>1071</u>
K.C.			
B.K.C.			
Ce.			
Cong sd	<u>3199</u>		<u>1418</u>
Cong	<u>3224</u>		<u>1443</u>
M.			
K.			
Mz.			
Me.			
V.			
S.	<u>3260</u>		<u>1479</u>
S.			
A	<u>3281</u>		<u>1500</u>
R.			
PE.			
G.			
TD.	<u>3288</u>		

Loc. in Sec. _____

NE NE NW

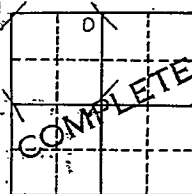
Geol. _____

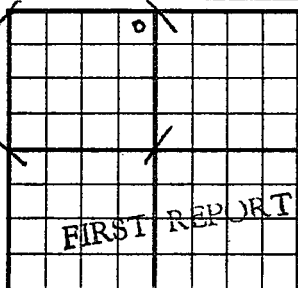
Contr. _____

Isern Drlg.

Pool _____

Geneseo-Edward

Date Comm. 3-23-55 JUN 1 19558 5/8" @ 270/175 DST 3273-81 open 1 hr.Rec. 10' ocm 990/20 DST 3282-88open 2 hr. Rec. 150' gas 150' hocom1035/20" TD 3288 5 1/2" @ 3282/100CO to 3288 250 A S/ 13 boph 6 hr.Comp. 40 bopd

County Ellsworth State KansasSec. 33 (Blk. Twp.) 17 (Sur. Rge.) 8W Map No.Operator Lebsack et al.Well No. 1 Farm KunkleElev. Location NE NE NW330 Ft. From N Line NW330 Ft. From E Line Quarter1st. Report MAR 23 1955

Completion

Remarks

Isern - Contr.

Spudding Date

Drilg. Data Geneseo-Edwards PoolMIR

FABEN GILSTRAP