


Section 33 Township 17 Range 8-W

Well No. 1 Kunkle "A"

Company Continental et al

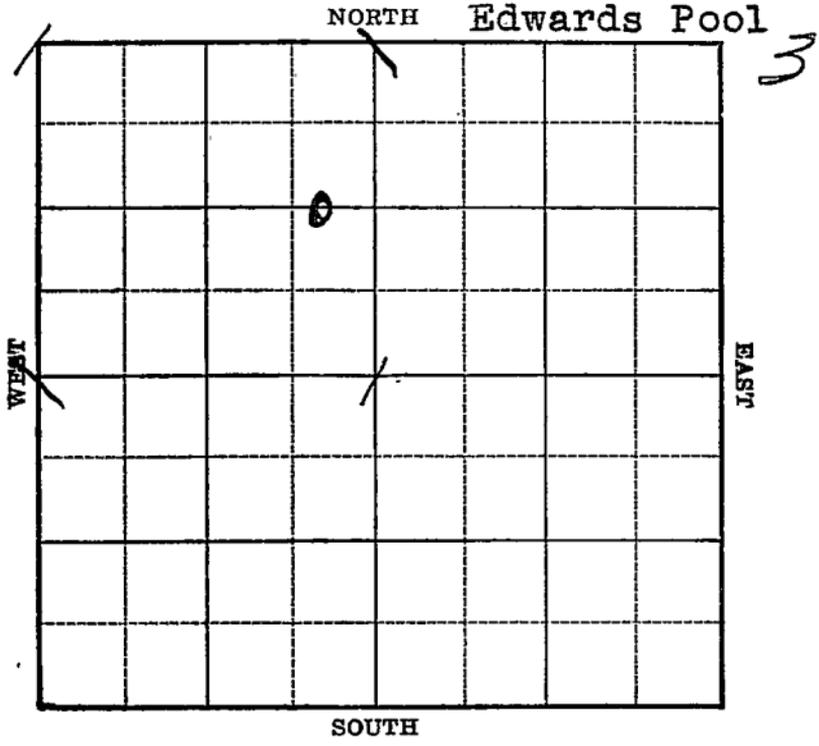



Map No. 48 Sec. 33 Twp. 17 R. 8WWell No. 1 Kunkle "A"Continental etal Company

Contractor

## FIRST REPORT

C E L NW

1320 Ft. from N. Line


\_\_\_\_\_ Ft. from S. Line

440 Ft. from E. Line

\_\_\_\_\_ Ft. from W. Line

EDWARDS POOL

## SECTION PLAT

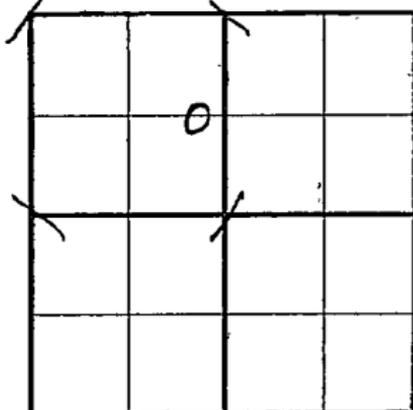

Location \_\_\_\_\_

Rig up \_\_\_\_\_

Drilling and Remarks:

RUR

## RECORD

Cased \_\_\_\_\_ in., \_\_\_\_\_ ft.

Sand \_\_\_\_\_

Gas \_\_\_\_\_

Oil \_\_\_\_\_

Total Depth \_\_\_\_\_

## PRODUCTION

1st 24 hrs. Nat. \_\_\_\_\_

1st 24 hrs. after shot \_\_\_\_\_

Gas \_\_\_\_\_ Cu. Ft.

Dry Hole \_\_\_\_\_

Abandoned \_\_\_\_\_

Date

MAR 1 - 1939 19 H. D. Hatfield Scout

Map No. 45 Sec. 33 Twp. 17 R. 8WWell No. 1 Kunkle "A"Continental etal

Company

Contractor

ABANDONED

C E L N W

1320 Ft. from N. Line

\_\_\_\_\_ Ft. from S. Line

440 Ft. from E. Line

\_\_\_\_\_ Ft. from W. Line

EDWARDS POOL

## SECTION PLAT

		0	

Location \_\_\_\_\_

## RECORD

Cased \_\_\_\_\_ in., \_\_\_\_\_ ft.

Sand Arb 3432

Gas \_\_\_\_\_

Oil \_\_\_\_\_

Total Depth 3520

## PRODUCTION

1st 24 hrs. Nat. \_\_\_\_\_

1st 24 hrs. after shot \_\_\_\_\_

Gas \_\_\_\_\_ Cu. Ft.

Dry Hole \_\_\_\_\_

Abandoned \_\_\_\_\_

Rig up \_\_\_\_\_

Drilling and Remarks:

Viola 3335Simp 3380Arb 3432T.O. 3520 S.W.DVA

Date

MAR 22 1939 19H. D. Hatfield

Scout