


Section 33 Township 17 Range 2W

Well No. 1 Rosander

Company Westgate-Greenland

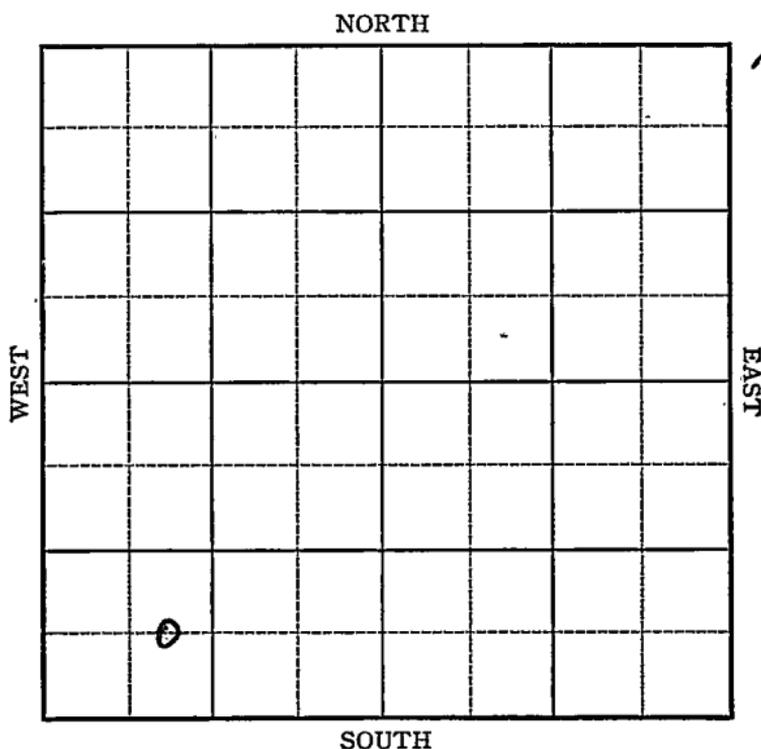



Map No. 42 Sec. 33 Twp. 17 R. 2WWell No. 1 RosanderWestgate-Greenland Company

Contractor

**FIRST REPORT**

C E L SW SW

         Ft. from N. Line660 Ft. from S. Line         Ft. from E. Line990 Ft. from W. Line

WILDCAT

**SECTION PLAT**


Location         Rig up         

Drilling and Remarks:

Derrick

**RECORD**Cased          in.,          ft.Sand         Gas         Oil         Total Depth         **PRODUCTION**1st 24 hrs.-Nat.         1st 24 hrs. after shot         Gas          Cu. Ft.Dry Hole         Abandoned         

Date

JUN 11 1941

19

S. J. LEWIS Scout

Map No. 42 Sec. 33 Twp. 17 R. 2W

Well No. 1 Rosander

Westgate-Greenland Company

ABANDONED Contractor

C E L SW SW

SECTION PLAT


\_\_\_\_\_ Ft. from N. Line

660 Ft. from S. Line

\_\_\_\_\_ Ft. from E. Line

990 Ft. from W. Line

WILDCAT

RECORD

Location \_\_\_\_\_

Cased \_\_\_\_\_ in., \_\_\_\_\_ ft.

Rig up \_\_\_\_\_

Sand \_\_\_\_\_

Drilling and Remarks:

Gas \_\_\_\_\_

Oil \_\_\_\_\_

Total Depth 3035

*Chas 2998*  
*No shows*

PRODUCTION

1st 24 hrs. Nat. \_\_\_\_\_

1st 24 hrs. after shot \_\_\_\_\_

Gas \_\_\_\_\_ Cu. Ft.

Dry Hole \_\_\_\_\_

Abandoned \_\_\_\_\_

Date

JUL 1 1941 19

S. J. LEWIS Scout