


KANSAS

Section 33 Township 17 Range 1W

Well No. 1 Hart

Company Mallard Drlg.

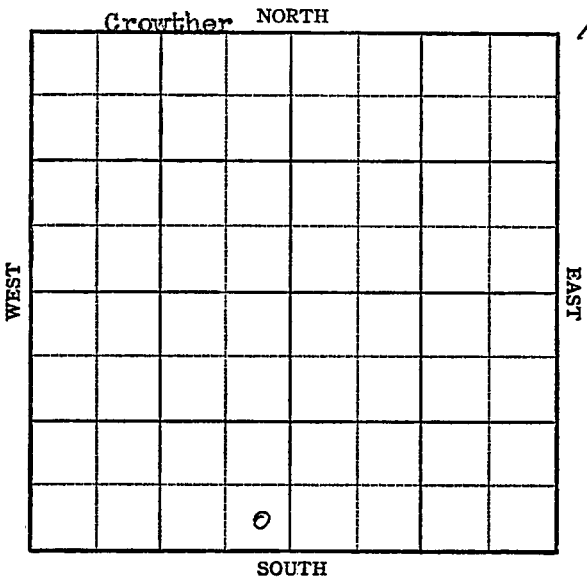

KANSAS

McPherson ✓

Sec. 33 Twp. 17 R. 1W

Well No. #1 Hart Farm

Mallard Drlg. Company

Crowther


_____ Ft. from N. Line

330 Ft. from S. Line

330 Ft. from E. Line

_____ Ft. from W. Line

SE SW

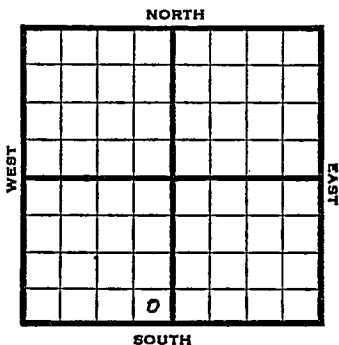

1947

Elev. 1352' REPORT

8/27

R U R

9/3

Lansing 2120
Mississippi 2689-98
TD 5" @ 2690 Rust

9/10

Drlg. 2721'
SSO

9/17

Miss. 2689'
5" @ 2690'
Total Depth 2735'

ABANDONED

Map No. _____ Sec. 33 Twp. 17 R. 1W

Well No. 1 Hart

Mallard Drlg. Company

FIRST REPORT

Contractor

SE SW

SECTION PLAT

_____ Ft. from N. Line

330 Ft. from S. Line

330 Ft. from E. Line

_____ Ft. from W. Line

McPherson County

Location _____

Rig up _____

Drilling and Remarks:

R U R

RECORD

Cased _____ in., _____ ft.

Sand _____

Gas _____

Oil _____

Total Depth _____

PRODUCTION

1st 24 hrs. Nat. _____

1st 24 hrs. after shot _____

Gas _____ Cu. Ft.

Dry Hole _____

Abandoned _____

Date

AUG 27 1947

19

S. J. LEWIS

Scout

