


KANSAS

Section 33 Township 17 Range 1W

Well No. #1 Cassler

Company Westgate Greenland

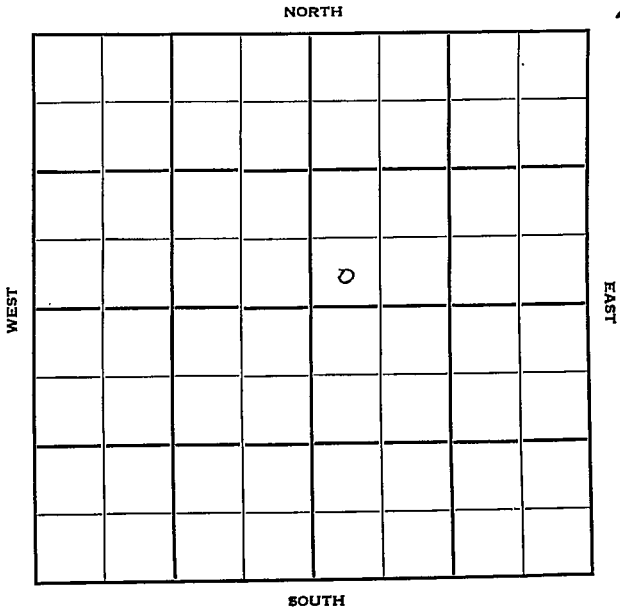

33

17

1W ✓

Sec. _____ Twp. _____ R. _____

Well No. #1 Gassler _____ Farm

Westgate-Greenland _____ Company

Contractor _____

_____ Ft. from N. Line

330'


_____ Ft. from S. Line

_____ Ft. from E. Line

330'

_____ Ft. from W. Line

SW SW NE

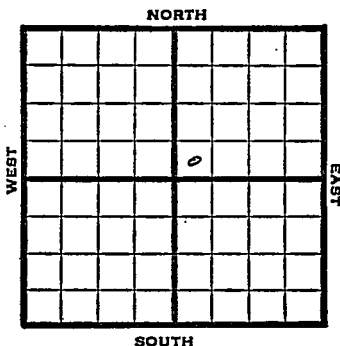

1950

Elev. 1342' REPORT

3/8

Spud 2-25-50
8-5/8" @ 160'
Chat 2684'
TD 2728'
D&A

**FIRST REPORT
ABANDONED**

Kansas

McPherson
KS

Map No. _____ Sec. 33 Twp. 17 R. 1W

Well No. 1 Cassler

Westgate-Greenland Company

Contractor

SW SW NE

El. 1342

SECTION PLAT

_____ Ft. from N. Line

330 Ft. from S. Line

_____ Ft. from E. Line

330 Ft. from W. Line



Location _____

Rig up _____

Drilling and Remarks:

Spud 2-25-50

8 5/8" @ 160

Chat 2684

TD 2728

D & K

RECORD

Cased _____ in., _____ ft.

Sand _____

Gas _____

Oil _____

Total Depth _____

PRODUCTION

1st 24 hrs. Nat. _____

1st 24 hrs. after shot _____

Gas _____ Cu. Ft.

Dry Hole _____

Abandoned _____

Date

MAR 8 1950

19

J. E. TYRA Scout