


Section 33 Township 17 Range 1W

Well No. 2 Hart

Company Westgate-Greenland & Mallard

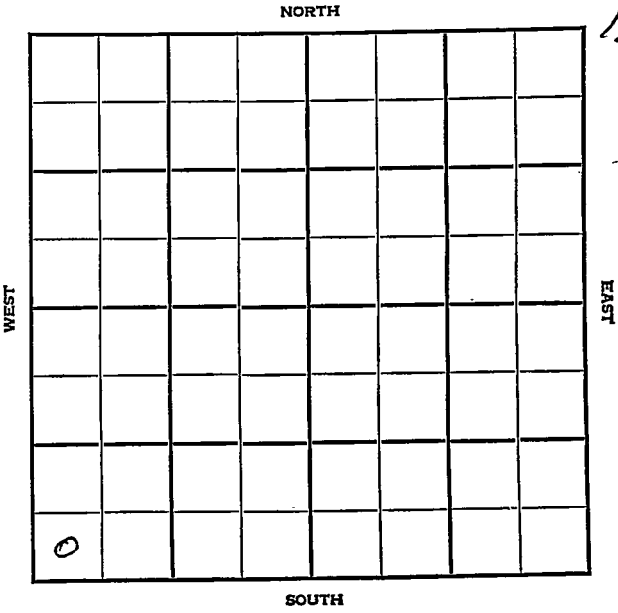

13

0

Sec. 33 Twp. 17 R. 1W

Well No. #2 Hart Farm \_\_\_\_\_

Westgate-Greenland & Mallard Company

~~SW~~ Crowther


\_\_\_\_\_ Ft. from N. Line

330 Ft. from S. Line

\_\_\_\_\_ Ft. from E. Line

330 Ft. from W. Line

SW/C

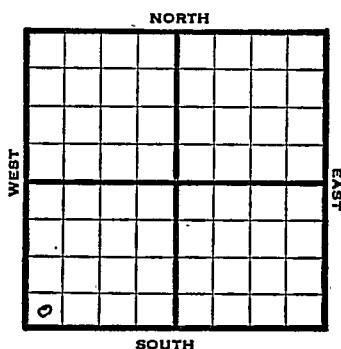

1947 Elev. 1363' REPORT

12/17	Location
12/30	"
1948	
1/7	"
1/14	"
1/21	10" @ 140' Drlg. 1775'
1/26	Lansing 2120' Mississippi 2685' TD 2715' 5" @ 2713' RMST
2/4	"
2/11	500 acid.
2/18	Miss. 2685' 5" @ 2713' 1250 acid TD 2717' Abd.

**ABANDONED**

Map No. \_\_\_\_\_ Sec. 33 Twp. 17 R. 1W

Well No. 2 Hart

Westgate-Greenland & Malleo Company

**FIRST REPORT**

Contractor

SW/C

**SECTION PLAT**

\_\_\_\_\_ Ft. from N. Line

330 Ft. from S. Line

\_\_\_\_\_ Ft. from E. Line

330 Ft. from W. Line


McPherson County

Location \_\_\_\_\_ X \_\_\_\_\_

Rig up \_\_\_\_\_

Drilling and Remarks:

**RECORD**

Cased \_\_\_\_\_ in., \_\_\_\_\_ ft.

Sand \_\_\_\_\_

Gas \_\_\_\_\_

Oil \_\_\_\_\_

Total Depth \_\_\_\_\_

**PRODUCTION**

1st 24 hrs. Nat. \_\_\_\_\_

1st 24 hrs. after shot \_\_\_\_\_

Gas \_\_\_\_\_ Cu. Ft.

Dry Hole \_\_\_\_\_

Abandoned \_\_\_\_\_

Date \_\_\_\_\_

DEC 17 1947 19

S I LEWIS Scout

