


Ellsworth

KANSAS

Section 34 Township 17 Range 8-WWell Number 1 J.F. RolfeCompany Continental

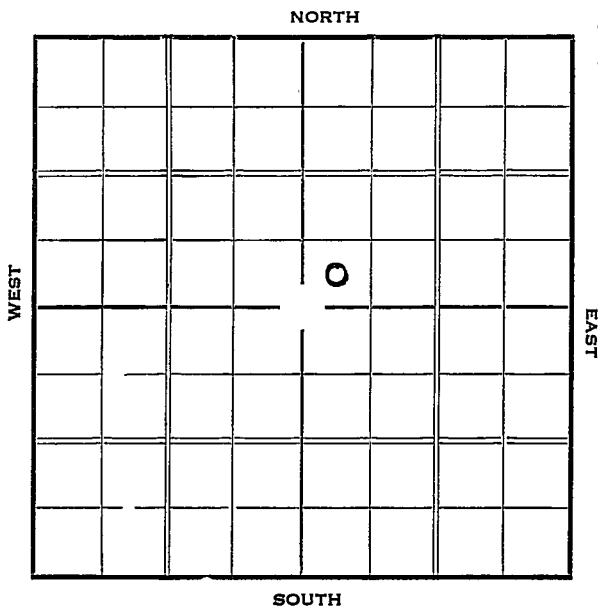

Form 26-1M Rls. 2-29 **KANSAS**

Map No. 45 Sec. 34 Twp. 17 R. 8W

Well No. 1 J. F. Koffe

Continental Company

Contractor

**SECTION PLAT**

|  |  |   |  |
|--|--|---|--|
|  |  |   |  |
|  |  |   |  |
|  |  | o |  |
|  |  |   |  |

     Ft. from N. Line

330 Ft. from S. Line

     Ft. from E. Line

330 Ft. from W. Line

**FIRST REPORT**

Location                     

Rig up                     

Drilling and Remarks:

*Rig*

**RECORD**

Cased          in.,          ft.

Sand                     

Gas                     

Oil                     

Total Depth                     

**PRODUCTION**

1st 24 hrs. Nat.                     

1st 24 hrs. after shot                     

Gas                      Cu. Ft.

Dry Hole                     

Abandoned                     

Date

DEC 20 1919

S. J. LEWIS

Scout

E. C. WORTH KANSAS

Map No. 45 Sec. 34 Twp. 17 R. 8WWell No. 1. J. F. R. & E.Continental Company

Contractor

## SECTION PLAT

|  |  |   |  |
|--|--|---|--|
|  |  |   |  |
|  |  | 0 |  |
|  |  |   |  |
|  |  |   |  |

       Ft. from N. Line330 Ft. from S. Line       Ft. from E. Line230 Ft. from W. Line

COMPLETED

Location                     Rig up                     

Drilling and Remarks:

Oil 32434000 acidPotential 1107

## RECORD

Cased        in.,        ft.Sand                     Gas                     Oil                     Total Depth 3256

## PRODUCTION

1st 24 hrs. Nat.                     1st 24 hrs. after shot                     Gas                      Cu. Ft.Dry Hole                     Abandoned                     

Date

FEB 17 1937 19

S. J. LEWIS Scout