
FORM 51 25M 8-50 WESTERN Ellsworth KANSAS

Section 34 Township 17 Range 8 W

Well No. # 1 Edwards

Company ~~Stag Drlg. Co. et al~~

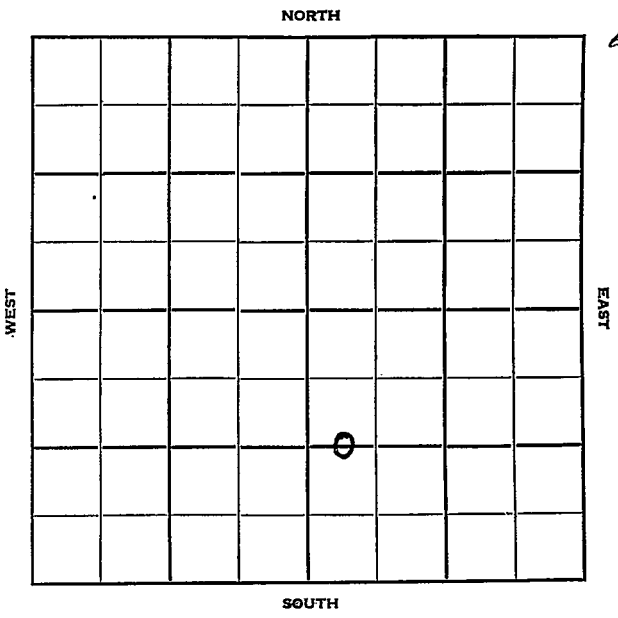

FORM 252-B

Ellsworth KANSAS

Sec. 34 Twp. 17 R. 8W

Well No. #1 Edwards Farm

Stag Drlg. Co. et al Company

Stag Drlg. Contractor

Edwards Pool


Ft. from N. Line

1320 Ft. from S. Line

Ft. from E. Line

330 Ft. from W. Line

C W½ W½ SE

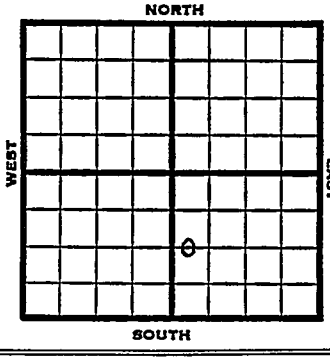

1953	Elev. 1786' REPORT
6/24	Spud 6-18-53 8" @ 220' Drlg 2391'
7/1	5" set
7/8	Heeb 2712, Lans 3856, Cong 3209, Simp 3231, Arb 3234 RTD 3325 5" @ 3324
7/22	NR
7/29	"
8/12	"
8/19	"
9/16	"
9/23	Spud 6-18-53 Oil Well TD 3325' 8" @ 220' Heeb 2712, Lans 2856, Cong 3209. Simp 3231, Arb 3234 TD 3325' 5" @ 3324' CO to 3325 500 A Comp. 46 bopd 25% wtr.

COMPLETED

FORM 275 FOR SALE BY KANSAS BLUE PRINT CO.

County Ellsworth State Kansas

Sec. 34 (Blk. Twp.) 17 (Sur. Rge.) 8W Map No.

Operator Stag Drlg. Co. etal.

Well No. 1 Farm Edwards

Elev. Location C W½ W½ SE



1320 Ft. From S Line SE

330 Ft. From W Line Quarter

1st. Report JUN ? 4 1953

Completion

Remarks Stag Drlg. - Contr.

Spudding Date 6-18-53

Drlg. Data Edwards Pool

8" @ 220 drlg. 2391

J. G. McGEHEE

FORM 275 FOR SALE BY KANSAS BLUE PRINT CO.


County Ellsworth State Kansas

Sec. 34 (Blk. Twp.) 17 (Sur. Rge.) 8W Map No.

Operator Stag Drlg. etal.

Well No. 1 Farm Edwards

Elev. 1786 Location C W½ W½ SE

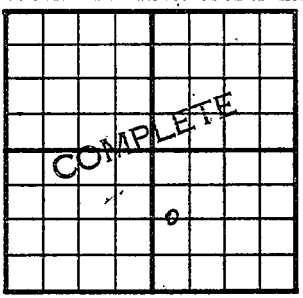

1320Ft. From S Line SE

330Ft. From W Line Quarter

1st. Report

Completion SEP 23 1953

Remarks Edwards Pool

Stag Drlg. - Contr.

Spudding Date 6-18-53

Drlg. Data Oil well TD 3325

8" @ 220 Heeb. 2712 Lans. 2856

Cong. 3209 Simp. 3231 Arb. 3234

TD 3325 5" @ 3324 CO to 3325 500-A

Comp. 46 bopd 25% wtr.

J. G. McGEHEE