


Section 34 Township 17 Range 8-W

Well Number 2-Edwards

Company Jim Davis et al

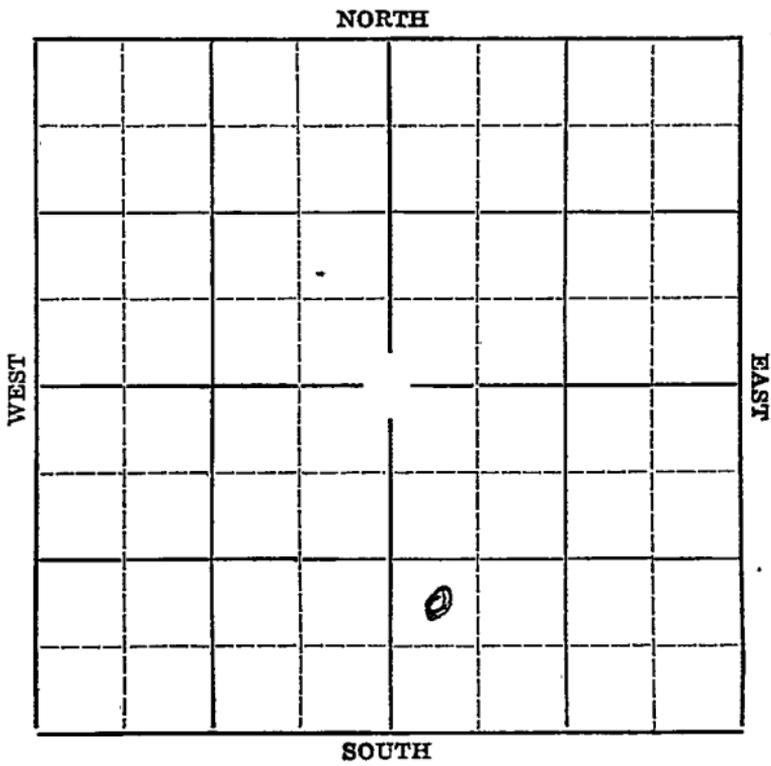



KANSAS

Map No. 45 Sec. 34 Twp. 17 R. 8W

Well No. 2 Edwards

Jim Davis & Co. Company  
Contractor

## SECTION PLAT

		0	

..... Ft. from N. Line

990 Ft. from S. Line

..... Ft. from E. Line

330 Ft. from W. Line

## FIRST REPORT

Location.....

Rig up.....

Drilling and Remarks:

Ponds.

## RECORD

Cased..... in., ..... ft.

Sand.....

Gas.....

Oil.....

Total Depth.....

## PRODUCTION

1st 24 hrs. Nat.....

1st 24 hrs. after shot.....

Gas..... Cu. Ft.

Dry Hole.....

Abandoned.....

Date

APR 22 1936 192

Scout

Edwards ~~Form 26 - 10 LBS. 2729~~

Map No. **KANSAS** Sec. 34 Twp. 17 R. 5W

Well No. 2 Edwards

Harris & Gal Company

Contractor

**SECTION PLAT**

		o	

\_\_\_\_\_ Ft. from N. Line

990 Ft. from S. Line

\_\_\_\_\_ Ft. from E. Line

330 Ft. from W. Line

COMPLETE

Location \_\_\_\_\_

Rig up \_\_\_\_\_

Drilling and Remarks:

*Sil 3235*

*Potential 1480*

*22 hrs.*

**RECORD**

Cased \_\_\_\_\_ in., \_\_\_\_\_ ft.

Sand \_\_\_\_\_

Gas \_\_\_\_\_

Oil \_\_\_\_\_

Total Depth 3242

**PRODUCTION**

1st 24 hrs. Nat. \_\_\_\_\_

1st 24 hrs. after shot \_\_\_\_\_

Gas \_\_\_\_\_ Cu. Ft.

Dry Hole \_\_\_\_\_

Abandoned \_\_\_\_\_

Date

JUN 10 1936

**LEWIS**

Scout