


Section 34 Township 17 Range 8-W

Well Number 3-Edwards

Company J.Davis

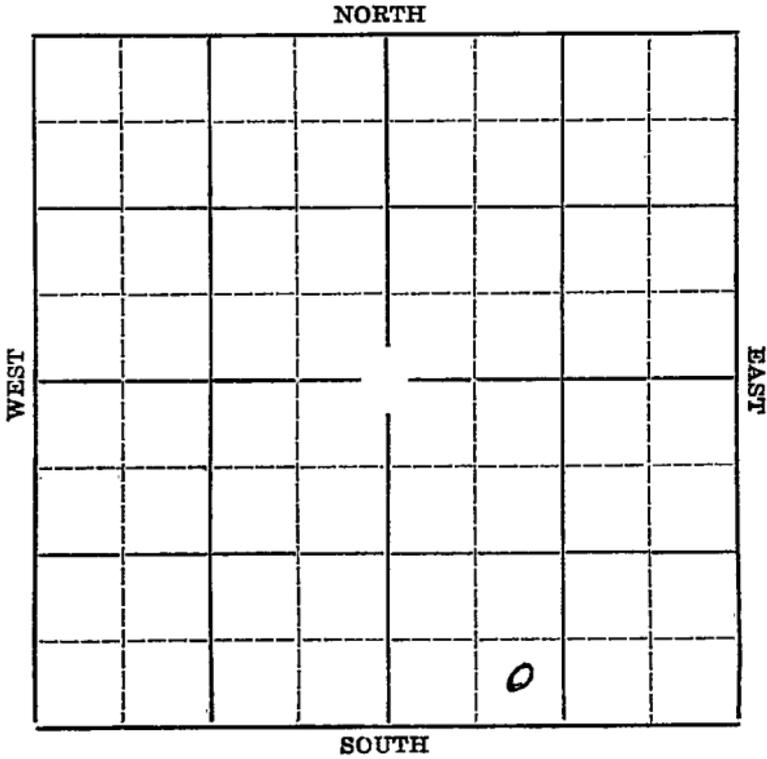

Map No.            Sec. 34 Twp. 17 R. 8W

Well No. #3 Edwards Farm

J. Davis Company


           Ft. from N. Line

330' Ft. from S. Line

           Ft. from E. Line

990' Ft. from W. Line

Elev. 1785

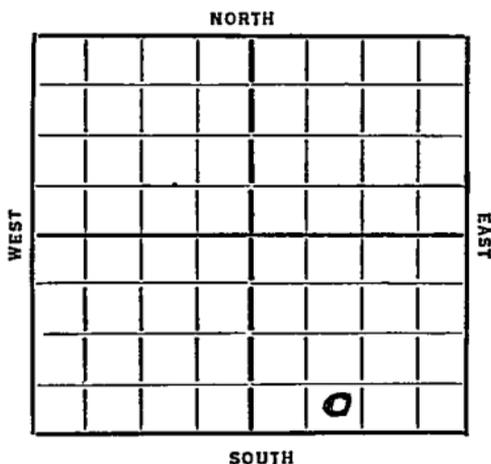

Date  
1936

REPORT

- 5/13 Cellar.
- 5/21 Building rig.
- 5/28 -- 6/4--
- 6/11 Rigging up.
- 6/18 Drlg. 350'.
- 6/25 Drlg. 1545'.
- 7/2 Drlg. 2092'.
- 7/9 K.C. 2855'. Show oil 2886-94'.  
Drlg. 2995'.
- 7/16 Sil. 3255'. Drlg 3290'.
- 7/23 Hole full water 3325-28'. TD 3418'.  
Under ream 6" Will make a water  
disposal well.
- 7/30 Hole full water 3456'. Drlg. 3634'.  
in Silicious.
- 8/6 Water disposal well.
- 8/13 --
- 8/19/36-Sil. 3328'. Regan 3823'.  
Granite Wash 3857'. TD 3880'.  
Water disposal well.

ABANDONED

Map No. 45 Sec. 34 Twp. 17 R. 8W

Well No. 3 Edwards

J. Harris Company  
Contractor

**SECTION PLAT**


\_\_\_\_\_ Ft. from N. Line

330 Ft. from S. Line

\_\_\_\_\_ Ft. from E. Line

990 Ft. from W. Line

**FIRST REPORT**

Location \_\_\_\_\_

Rig up \_\_\_\_\_

Drilling and Remarks:

*Cellar*

**RECORD**

Cased \_\_\_\_\_ in., \_\_\_\_\_ ft.

Sand \_\_\_\_\_

Gas \_\_\_\_\_

Oil \_\_\_\_\_

Total Depth \_\_\_\_\_

**PRODUCTION**

1st 24 hrs. Nat. \_\_\_\_\_

1st 24 hrs. after shot \_\_\_\_\_

Gas \_\_\_\_\_ Cu. Ft.

Dry Hole \_\_\_\_\_

Abandoned \_\_\_\_\_

Date

**MAY 13 1936**

19

**S. J. LEWIS**

Scout

KANSAS

Form 26 - 11th Ed. - 8-29

Map No. 43 Sec. 34 Twp. 17 R. SW

Well No. 3 Edwards

Tavis Company

Contractor

SECTION PLAT


     Ft. from N. Line

930 Ft. from S. Line

     Ft. from E. Line

990 Ft. from W. Line

~~COMPLETED~~

ABANDONED

Location     

Rig up     

Drilling and Remarks:

*Sil 3328*  
*Regan 3823*  
*Granite Wash 3857*  
*Water disposal*  
*well*

RECORD

Cased      in.,      ft.

Sand     

Gas     

Oil     

Total Depth 3880

PRODUCTION

1st 24 hrs. Nat.     

1st 24 hrs. after shot     

Gas      Cu. Ft.

Dry Hole     

Abandoned     

Date

AUG 19 1936 19

S. J. LEWIS Scout