


Section 34 Township 17 Range 8-W

Well Number #5-Jansen "B"

Company ~~Empire~~ Continental et al

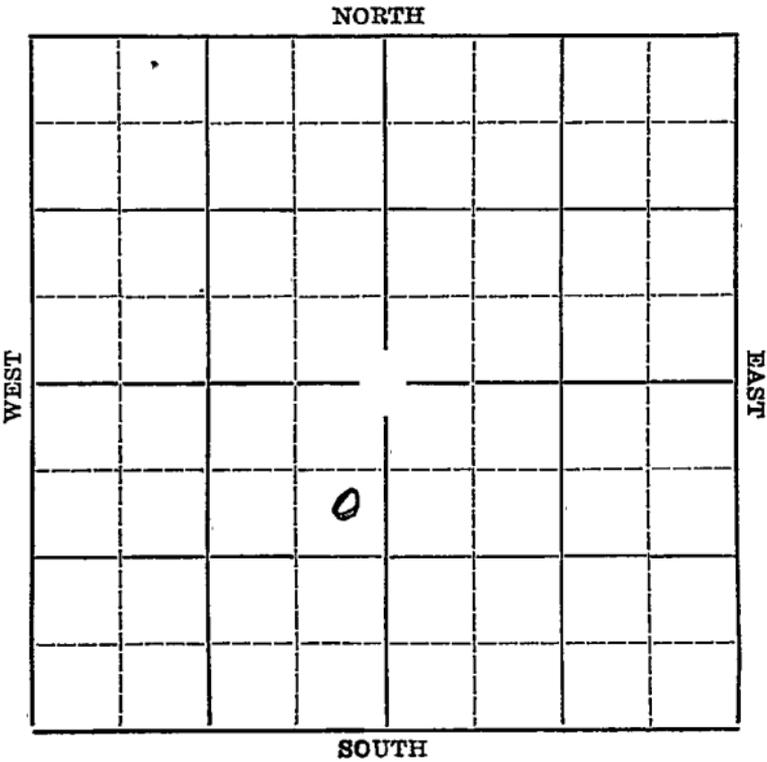




Contractor

SECTION PLAT

990 Ft. from N. Line

_____ Ft. from S. Line

_____ Ft. from E. Line

330 Ft. from W. Line

FIRST REPORT

Location ✓

Rig up _____

Drilling and Remarks:

RECORD

Cased _____ in., _____ ft.

Sand _____

Gas _____

Oil _____

Total Depth _____

PRODUCTION

1st 24 hrs. Nat. _____

1st 24 hrs. after shot _____

Gas _____ Cu. Ft.

Dry Hole _____

Abandoned _____

Date

SEP 23 1936 19

S. J. LEWIS Scout

Map No. 45 Sec. 34 Twp. 17 R. 8W

Well No. 5 James B

Continental Oil Company

Contractor

SECTION PLAT

290 Ft. from N. Line

_____ Ft. from S. Line

_____ Ft. from E. Line

330 Ft. from W. Line

CORRECTION

Location _____

Rig up _____

Drilling and Remarks:

*Was Empire
Continental
is going to operate
this lease.*

RECORD

Cased _____ in., _____ ft.

Sand _____

Gas _____

Oil _____

Total Depth _____

PRODUCTION

1st 24 hrs. Nat. _____

1st 24 hrs. after shot _____

Gas _____ Cu. Ft.

Dry Hole _____

Abandoned _____

Date

NOV. 4 1936

19

S. J. LEWIS

Scout

Map No. 45 Sec. 34 Twp. 17 R. 8W

Well No. 5 Jansen B

Continental Company

Contractor

SECTION PLAT

		o	

990 Ft. from N. Line

_____ Ft. from S. Line

_____ Ft. from E. Line

330 Ft. from W. Line

COMPLETED

Location _____

Rig up _____

Drilling and Remarks:

*Sil 3222.
4000 acid
640 oil
240 water*

RECORD

Cased _____ in., _____ ft.

Sand _____

Gas _____

Oil _____

Total Depth 3271

PRODUCTION

1st 24 hrs. Nat. _____

1st 24 hrs. after shot _____

Gas _____ Cu. Ft.

Dry Hole _____

Abandoned _____

Date

NOV 10 1936 19

S. J. LEWIS Scout