

KANSAS

Ellsworth


Form 51-5M-4-36-Palace

O.W.O.

Section 34 Township 17 Range 8-W

Well Number #6 Jansen "B"

Company ~~Empire~~ Continental et al

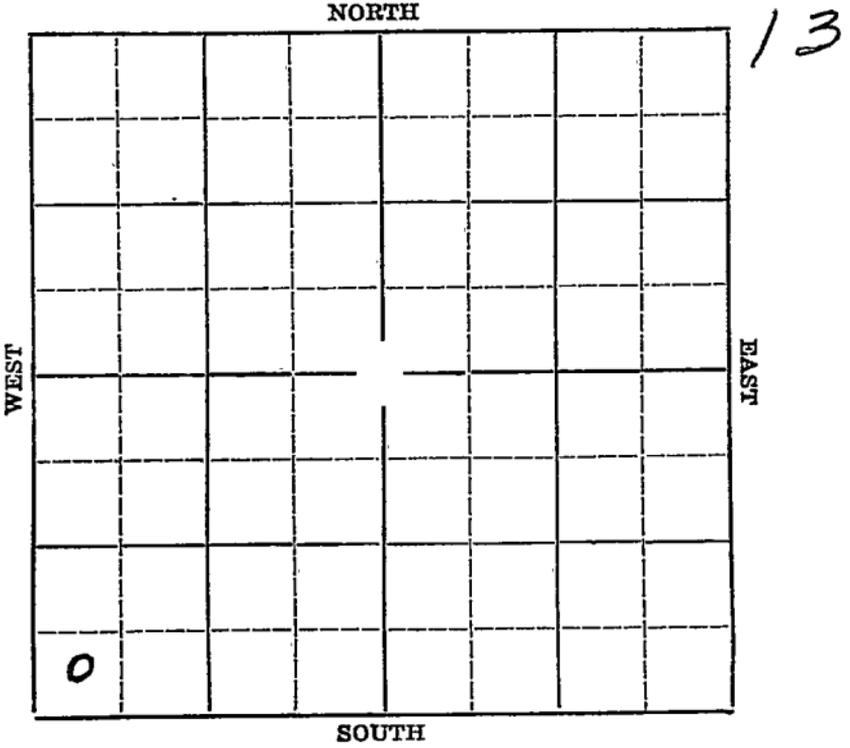

KANSAS

Form 26-1M Bks. 229

Map No. 45 Sec. 34 Twp. 17 R. 8W

Well No. 6 Jansen "B"

Enterprise Company

Contractor

SECTION PLAT

0			

_____ Ft. from N. Line

330 Ft. from S. Line

_____ Ft. from E. Line

330 Ft. from W. Line

FIRST REPORT

Location _____

Rig up _____

Drilling and Remarks:

Rig

RECORD

Cased _____ in., _____ ft.

Sand _____

Gas _____

Oil _____

Total Depth _____

PRODUCTION

1st 24 hrs. Nat. _____

1st 24 hrs. after shot _____

Gas _____ Cu. Ft.

Dry Hole _____


Abandoned _____

Date

OCT 21 1936 19

S. J. LEWIS Scout

RECEIVED
NOV 12 1903

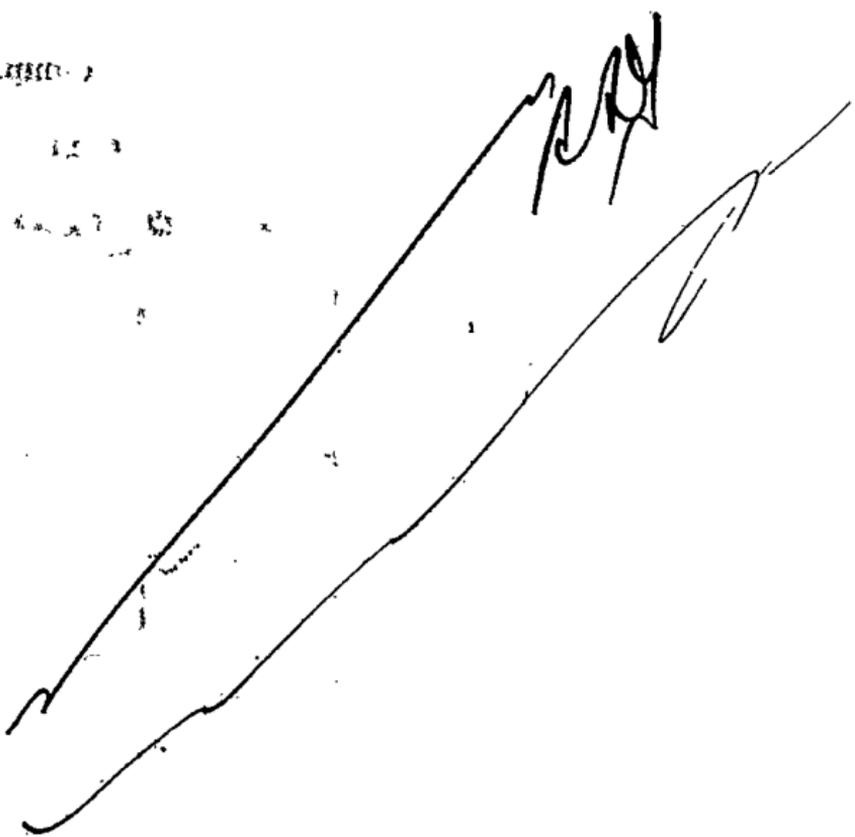

Returned	<i>[Signature]</i>
Cards	<i>[Signature]</i>
Tracing	<i>[Signature]</i>
France Map	<i>[Signature]</i>
Scarborough Map	<i>[Signature]</i>
Moody Map	<i>[Signature]</i>
Scarborough Plat Book	
Moody Plat Book	

Map No. 45 Sec. 24 Twp. 17 R. 8W

Well No. 6 Janice "B"

Continental Oil Company

Contractor

SECTION PLAT

_____ Ft. from N. Line

330 Ft. from S. Line

_____ Ft. from E. Line

330 Ft. from W. Line

CORRECTION

Location _____

Rig up _____

Drilling and Remarks:

Was Empire

Continental Oil

going to operate

this lease

RECORD

Cased _____ in., _____ ft.

Sand _____

Gas _____

Oil _____

Total Depth _____

PRODUCTION

1st 24 hrs. Nat. _____

1st 24 hrs. after shot _____

Gas _____ Cu. Ft.

Dry Hole _____

Abandoned _____

Date

NOV 4 1936 19

S. J. LEWIS

Scout

Handwritten signature

Returned	<i>Handwritten mark</i>
Cards	<i>Handwritten mark</i>
Tracing	<i>Handwritten mark</i>
France Map	<i>Handwritten mark</i>
Scarborough Map	<i>Handwritten mark</i>

Form 28-1M-PLS-228 **KANSAS**

Map No. 45 Sec. 34 Twp. 17 R. 8W

Well No. 6. Jansen B

Continental & Co. Company

Contractor

SECTION PLAT

_____ Ft. from N. Line

330 Ft. from S. Line

_____ Ft. from E. Line

330 Ft. from W. Line

COMPLETED

Location _____

Rig up _____

Drilling and Remarks:

Sil 3255
4000 acid
28553

RECORD

Cased _____ in., _____ ft.

Sand _____

Gas _____

Oil _____

Total Depth 3270

PRODUCTION

1st 24 hrs. Nat. _____

1st 24 hrs. after shot _____

Gas _____ Cu. Ft.

Dry Hole _____

Abandoned _____

Date

DEC 2 1936

S. J. LEWIS Scout

Returned _____
 Cards *Paul* _____
 Tracing *Joe* _____
 France Map _____
 Scarborough Map _____
 Moody Map _____
 Scarborough Plat Book _____
 Moody Plat Book _____

Paul

Scout Cards
Land Small Map
Land Wall Map
Tracings
France Map
Pierce Map
Misc.

18 1951

AUG 16 1957

Scout Cards	<i>OK</i>
Land Small Map	
Land Wall Map	<i>3</i>
Tracings	
France Map	
Pierce Map	
Misc.	