


Ellsworth

KANSAS

Section 34 Township 17 Range 8-W

Well Number 8 Jansen "B"

Company Continental et al

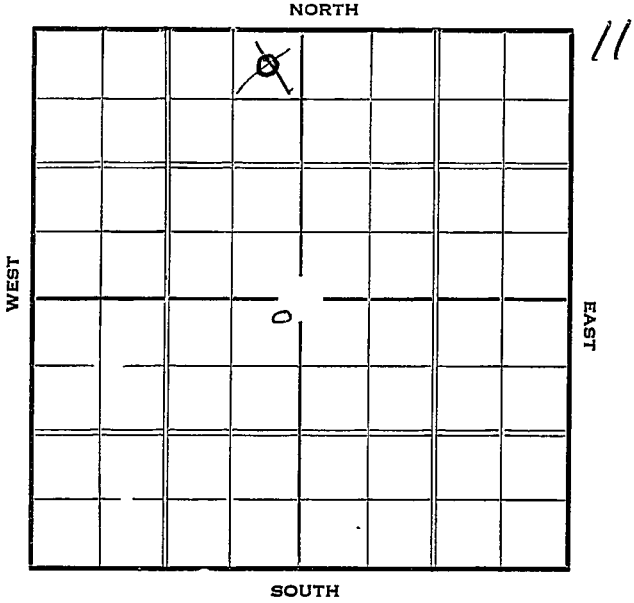

Map No. \_\_\_\_\_ Sec. 34 Twp. 17 R. 8-W

Well No. #8 Jansen "B" Farm \_\_\_\_\_

\_\_\_\_\_ Continental et al Company \_\_\_\_\_


330 Ft. from N. Line

\_\_\_\_\_ Ft. from S. Line

330 Ft. from E. Line

\_\_\_\_\_ Ft. from W. Line

Elev. 1787

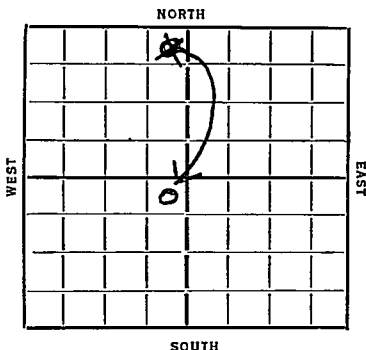

Date	REPORT
1936	
12/22	Rig
12/29	13" @ 195'. Drlg. 1155'.
1937	
1/7	Drlg. 2860'.
1/14	Sil. 3217'. 8" @ 3218'.
	T. D. 3223'. RUST.
1/21	Pay 3249-50' T.D. 2700' oil.
1/28	4000 acid. On potential.
2/3	Sil. 3217'.
	T. D. 3250'.
	4000 acid.
	Potential 1249.
	<b>COMPLETED</b>

# KANSAS

Map No. 45 Sec. 34 Twp. 17 R. 8W

Well No. 8 Jansen "B"

Continental & Co Company

Contractor

### SECTION PLAT

330 Ft. from N. Line

\_\_\_\_\_ Ft. from S. Line

330 Ft. from E. Line

\_\_\_\_\_ Ft. from W. Line

		8	

### FIRST REPORT

Location \_\_\_\_\_

Rig up \_\_\_\_\_

Drilling and Remarks:

*Rig*

### RECORD

Cased \_\_\_\_\_ in., \_\_\_\_\_ ft.

Sand \_\_\_\_\_

Gas \_\_\_\_\_

Oil \_\_\_\_\_

Total Depth \_\_\_\_\_

### PRODUCTION

1st 24 hrs. Nat. \_\_\_\_\_

1st 24 hrs. after shot \_\_\_\_\_

Gas \_\_\_\_\_ Cu. Ft.

Dry Hole \_\_\_\_\_

Abandoned \_\_\_\_\_

Date

DEC 22 1936 19

S. J. LEWIS Scout

Map No. 48 Sec. 34 Twp. 19 R. 8W

Well No. 5 Jensen "B"

Continental & Co Company

Contractor

**SECTION PLAT**

		o	

330 Ft. from N. Line

\_\_\_\_\_ Ft. from S. Line

330 Ft. from E. Line

\_\_\_\_\_ Ft. from W. Line

**CORRECTION**

Location \_\_\_\_\_

Rig up \_\_\_\_\_

Drilling and Remarks:

*Reported  
NE NW.*

**RECORD**

Cased \_\_\_\_\_ in., \_\_\_\_\_ ft.

Sand \_\_\_\_\_

Gas \_\_\_\_\_

Oil \_\_\_\_\_

Total Depth \_\_\_\_\_

**PRODUCTION**

1st 24 hrs. Nat. \_\_\_\_\_

1st 24 hrs. after shot \_\_\_\_\_

Gas \_\_\_\_\_ Cu. Ft.

Dry Hole \_\_\_\_\_

Abandoned \_\_\_\_\_

Date

JAN 6 1937 19

S. J. LEWIS Scout

# KANSAS

Map No. 45 Sec. 34 Twp. 17 R. SW

Well No. Jansen B

Continental et al. Company

Contractor

### SECTION PLAT

	0		

330 Ft. from N. Line

\_\_\_\_\_ Ft. from S. Line

330 Ft. from E. Line

\_\_\_\_\_ Ft. from W. Line

## COMPLETED

### RECORD

Cased \_\_\_\_\_ in., \_\_\_\_\_ ft.  
 Sand \_\_\_\_\_  
 Gas \_\_\_\_\_  
 Oil \_\_\_\_\_  
 Total Depth 3250

### PRODUCTION

1st 24 hrs. Nat. \_\_\_\_\_  
 1st 24 hrs. after shot \_\_\_\_\_  
 Gas \_\_\_\_\_ Cu. Ft.  
 Dry Hole \_\_\_\_\_  
 Abandoned \_\_\_\_\_

Location \_\_\_\_\_

Rig up \_\_\_\_\_

Drilling and Remarks:

Si 63217  
4000 acid  
Potential  
1249

Date

FEB 3 1937

19

LEWIS

Scout