


Section.....34.....Township.....17.....Range.....8-~~W~~


Well Number.....10 - Jansen "B".....

Company.....Continental.....

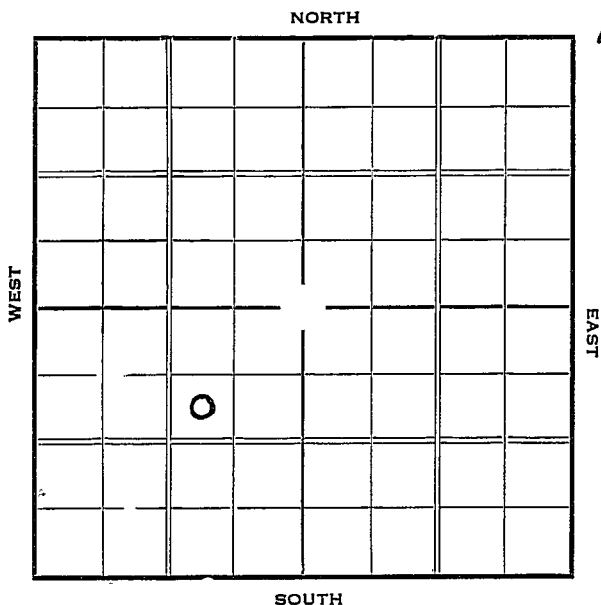

Sec. 34 Twp. 17 R. 8-WWell No. #10 Jansen "B" FarmContinental Company990 Ft. from N. Line Ft. from S. Line990 Ft. from E. Line Ft. from W. Line

Elev. 1787

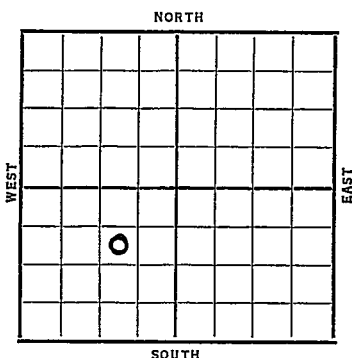

Date	REPORT
1937	
4/28	Location
5/7	B. R.
5/14	"
5/21	10" @ 172'. WOC.
5/28	Drlg. 2345'.
6/4	Drlg. 3100'.
6/11	Sil. 3215'. 7" @ 3217'.
	T.D. 3220'. RUST.
6/19	Drlg. 3250'. 2500' oil.
6/25	T.D. 3253'. Testing.
6/30	7" @ 3217'.
	Sil. 3215'.
	T.D. 3253'.
	Pot. 607 bbls.
	COMPLETED

Ellsworth

Map No. 45 Sec. 34 Twp. 17 R. 8^WWell No. 10-Jansen "B"Continental Company

Contractor

FIRST REPORT

SECTION PLAT

990 Ft. from N. Line Ft. from S. Line990 Ft. from E. Line Ft. from W. LineLocation ✓Rig up

Drilling and Remarks:

RECORD

Cased in., ft.Sand Gas Oil Total Depth

PRODUCTION

1st 24 hrs. Nat. 1st 24 hrs. after shot Gas Cu. Ft.Dry Hole Abandoned

Date

APR 28 1937 19

H. D. Hatfield Scout

KANSAS

Ellsworth

Map No. 45 Sec. 34 Twp. 17 R. 8WWell No. 10 - Jansen "B"Continental et al Company

Contractor

COMPLETED

SECTION PLAT

	0		

990 Ft. from N. Line

_____ Ft. from S. Line

990 Ft. from E. Line

_____ Ft. from W. Line

Location _____

Rig up _____

Drilling and Remarks:

Pat 607

RECORD

Cased 7 in., 3217 ft.Sand 511 3215

Gas _____

Oil _____

Total Depth 3253

PRODUCTION

1st 24 hrs. Nat. _____

1st 24 hrs. after shot _____

Gas _____ Cu. Ft.

Dry Hole _____

Abandoned _____

Date

JUN 30 1937

19

H. D. Hatfield

Scout