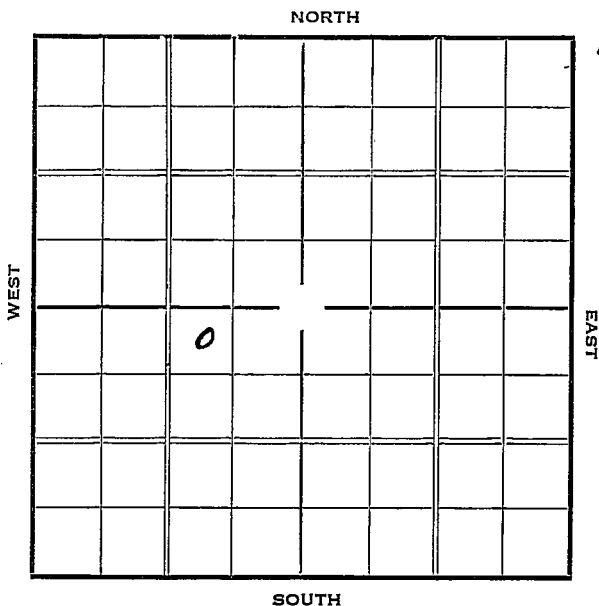


Section 34 Township 17 Range 8-WWell Number 11- Jansen "B"Company Continental et al

Sec. 34 Twp. 17 R. 8-W

Well No. #11 Jansen "B" Farm


Continental et al Company

330 Ft. from N. Line

_____ Ft. from S. Line

990 Ft. from E. Line

Ft. from W. Line

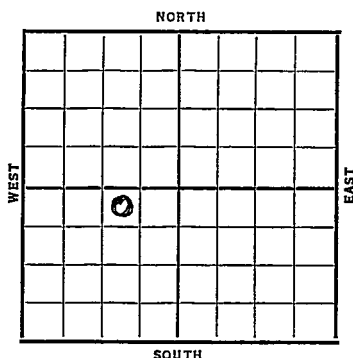

Date	REPORT
1937	
7/14	B. R.
7/23	10" @ 182'. Drlg. 915'.
7/30	Drlg. 2824'.
8/6	Sil. 3204'. 7" @ 3205'. T.D. 3210'.
	RUST.
8/13	T.D. 3236'. 2950' oil.
	Acidizing.
8/20	4000 acid.
8/25	7" @ 3205'
	Sil 3204'
	TD 3236'
	4000 acid
	Pot 740
	COMPLETED

Map No. 45 Sec. 34 Twp. 17 R. 8 W.Well No. 11 - Jansen "B"Continental et al Company

Contractor

FIRST REPORT

SECTION PLAT

350 Ft. from N. Line Ft. from S. Line990 Ft. from E. Line Ft. from W. Line

	0		

Location Rig up

Drilling and Remarks:

BR

RECORD

Cased in., ft.Sand Gas Oil Total Depth

PRODUCTION

1st 24 hrs. Nat. 1st 24 hrs. after shot Gas Cu. Ft.Dry Hole Abandoned

Date

JUL 14 1937 19H. D. Hatfield

Scout

KANSAS

Ellsworth

Map No. _____ Sec. 34 Twp. 17 R. 8 WWell No. 11-Jansen "B"Continental etal Company

Contractor _____

COMPLETED

SECTION PLAT

	0		

330 Ft. from N. Line

_____ Ft. from S. Line

990 Ft. from E. Line

_____ Ft. from W. Line

Location _____

Rig up _____

Drilling and Remarks:

4000 AcidPat- 740

RECORD

Cased 7 in. 3205 ft.Sand 511 3204

Gas _____

Oil _____

Total Depth 3236

PRODUCTION

1st 24 hrs. Nat. _____

1st 24 hrs. after shock _____

Gas _____ Cu. Ft.

Dry Hole _____

Abandoned _____

Date

AUG 25 1937

19

H. D. Hatfield Scout