

# KANSAS

Form 51-5M-7-39-Palace


Ellsworth Co., Kansas

Geneseo Pool

Section 34 Township 17 Range 8W

Well No. #12 Janssen "B"

Company Continental etal

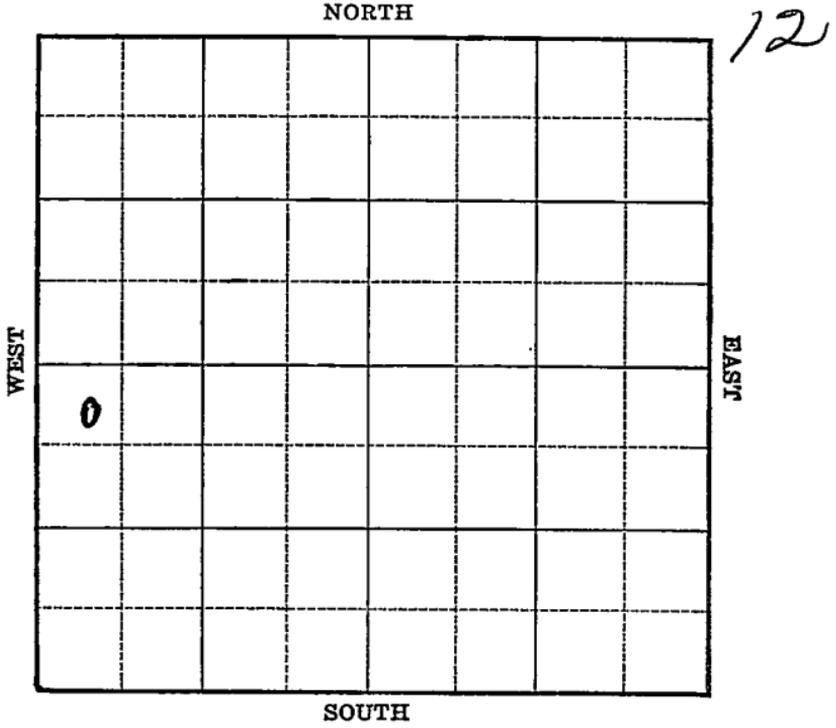



Map No. 45 Sec. 34 Twp. 17 R. 8W

Well No. 12 Janssen "B"

Continental etal Company

Contractor

### FIRST REPORT

### SECTION PLAT

NW SW

440 Ft. from N. Line

\_\_\_\_\_ Ft. from S. Line

\_\_\_\_\_ Ft. from E. Line

440 Ft. from W. Line

o			

GENESEO POOL

Location \_\_\_\_\_

Rig up \_\_\_\_\_

Drilling and Remarks:  
Rotary

### RECORD

Cased \_\_\_\_\_ in., \_\_\_\_\_ ft.

Sand \_\_\_\_\_

Gas \_\_\_\_\_

Oil \_\_\_\_\_

Total Depth \_\_\_\_\_

### PRODUCTION

1st 24 hrs. Nat. \_\_\_\_\_

1st 24 hrs. after shot \_\_\_\_\_

Gas \_\_\_\_\_ Cu. Ft.

Dry Hole \_\_\_\_\_

Abandoned \_\_\_\_\_

Date

JUN 26 1940  
19

S. J. LEWIS Scout

