

KANSAS

Form 51-5M-7-39-Palace


Ellsworth

Section 34 Township 17 Range 8-W

Well No. #8 Rolfs

Company Continental

NORTH Edwards Pool *2/*

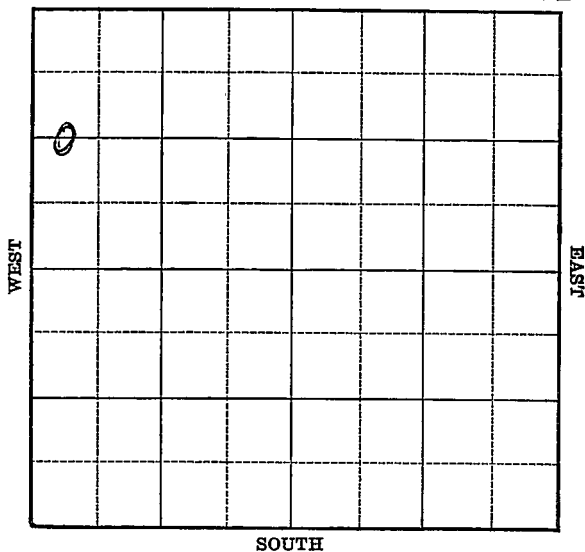

Ellsworth **KANSAS**Map No. 45 Sec. 34 Twp. 17 R. 8WWell No. 8 RolfsContinental

Company

Contractor

FIRST REPORT

C W L NW

1320 Ft. from N. Line

_____ Ft. from S. Line

_____ Ft. from E. Line

330 Ft. from W. Line**EDWARDS POOL****SECTION PLAT**

Location _____

Rig up _____

Drilling and Remarks:

Cellar**RECORD**

Cased _____ in., _____ ft.

Sand _____

Gas _____

Oil _____

Total Depth _____

PRODUCTION

1st 24 hrs. Nat. _____

1st 24 hrs. after shot _____

Gas _____ Cu. Ft.

Dry Hole _____

Abandoned _____

Date

OCT 11 1939

19

S. J. LEWIS

Scout

Map No. 45 Sec. 34 Twp. 17 R. 8W

Well No. 8 Rolfs

Continental Company

Contractor

COMPLETED

SECTION PLAT

C W L NW

1320 Ft. from N. Line

_____ Ft. from S. Line

_____ Ft. from E. Line

330 Ft. from W. Line

EDWARDS POOL

Location _____

Rig up _____

Drilling and Remarks: *

CE # 3182

7" @ 3183

Depthograph # 19109

Mapman

3000

RECORD

Cased _____ in., _____ ft.

Sand _____

Gas _____

Oil _____

Total Depth 3228

PRODUCTION

1st 24 hrs. Nat. _____

1st 24 hrs. after shot _____

Gas _____ Cu. Ft.

Dry Hole _____

Abandoned _____

Date

Nov 3 1939

Scout