


Section 34 Township 17 Range 8-W

Well Number 3 Rolfe (Rof's)

Company Continental et al

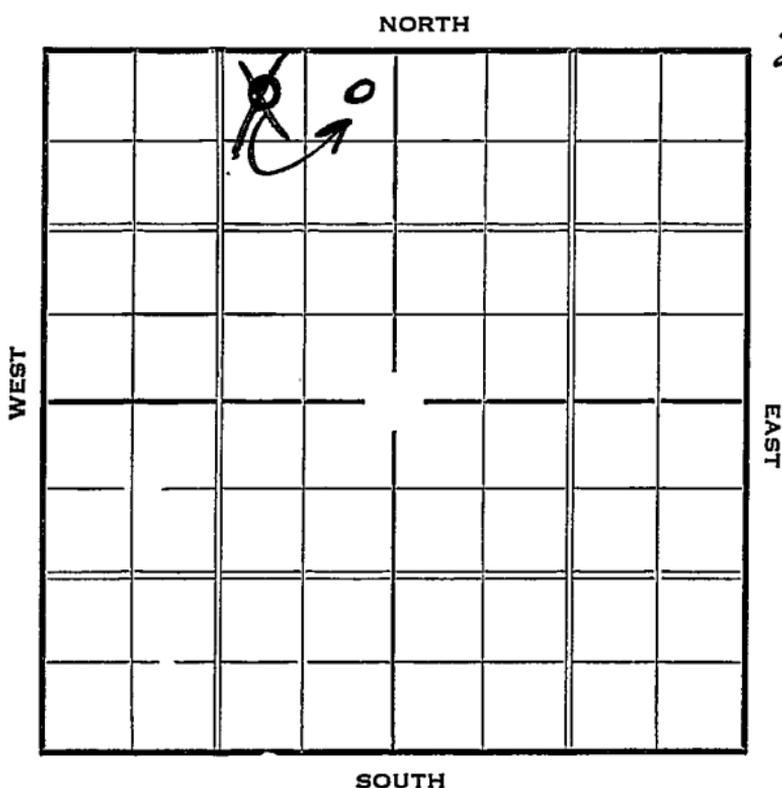

KANSAS

Ellsworth

Map No. 45 Sec. 34 Twp. 17 R. SW.Well No. 3 RolfeContinental & Co. Company

Contractor

SECTION PLAT

	o		

380 Ft. from N. Line

_____ Ft. from S. Line

990 Ft. from E. Line

_____ Ft. from W. Line

FIRST REPORT

Location ✓

Rig up _____

Drilling and Remarks:

RECORD

Cased _____ in., _____ ft.

Sand _____

Gas _____

Oil _____

Total Depth _____

PRODUCTION

1st 24 hrs. Nat. _____

1st 24 hrs. after shot _____

Gas _____ Cu. Ft.

Dry Hole _____

Abandoned _____

Date

APR 21 1937

19

S. I. LEWIS Scout

Ellsworth

Map No. 45 Sec. 34 Twp. 17 R. 8 W

Well No. 3 - Polys

Continental Etal Company

Contractor

CORRECTION

SECTION PLAT

330

330 Ft. from N. Line

_____ Ft. from S. Line

330 Ft. from E. Line

_____ Ft. from W. Line

	0		

CORRECTION

Location _____

Rig up _____

Drilling and Remarks:

*1st reported as
being in
NW NE NW*

RECORD

Cased _____ in., _____ ft.

Sand _____

Gas _____

Oil _____

Total Depth _____

PRODUCTION

1st 24 hrs. Nat. _____

1st 24 hrs. after shot _____

Gas _____ Cu. Ft.

Dry Hole _____

Abandoned _____

Date

MAY 5 - 1937 19

H. Hatfield Scout

Form 26 **KANSAS** Ellsworth

Map No. 45 Sec. 34 Twp. 17 R. 8 W

Well No. 5 - Ralls

Continental etal Company

Contractor

SECTION PLAT

	0		

COMPLETED
330 Ft. from N. Line
 _____ Ft. from S. Line
530 Ft. from E. Line
 _____ Ft. from W. Line

Location _____

Rig up _____

Drilling and Remarks:

*Pat 1403
nat.*

RECORD

Cased 7 in., 3259 ft.

Sand 511 3258

Gas _____

Oil _____

Total Depth 3265

PRODUCTION

1st 24 hrs. Nat. _____

1st 24 hrs. after shot _____

Gas _____ Cu. Ft.

Dry Hole _____

Abandoned _____

Date

JUN 16 1937 19

H. D. Hatfield

Scout